

STATE ENGINEER
Salem, Oregon

4/55
MAR 1955

Well Record


STATE WELL NO 6/2W-17B(1)
COUNTY Marion
APPLICATION NO. GR-427

OWNER: Assemblies of God, Ore. Dist. MAILING ADDRESS: Box 38

LOCATION OF WELL: Owner's No. #2 CITY AND STATE: Brooks, Oregon

NW 1/4 NE 1/4 Sec. 17 T. 6 N. S. R. 2 W., W.M.

Bearing and distance from section or subdivision corner 927' S. & 1336' W. from NE Cor. Sec. 17

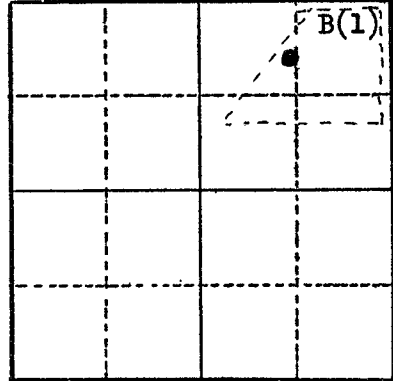

Section 17

Altitude at well 183

TYPE OF WELL: Drilled Date Constructed Aug. 1, 1944

Depth drilled 80 Depth cased 80

CASING RECORD:
6"

FINISH:

AQUIFERS:

WATER LEVEL:
40

PUMPING EQUIPMENT: Type Jet H.P. _____
Capacity 20 G.P.M.

WELL TESTS:
Drawdown _____ ft. after _____ hours _____ G.P.M.
Drawdown _____ ft. after _____ hours _____ G.P.M.

USE OF WATER Domestic & Camp meetings Temp. _____ °F. _____, 19____

SOURCE OF INFORMATION GR-427

DRILLER or DIGGER _____

ADDITIONAL DATA:
Log No Water Level Measurements _____ Chemical Analysis _____ Aquifer Test _____

REMARKS: