

STATE ENGINEER  
Salem, Oregon

4159  
MAR 1953  
Well Record

STATE WELL NO. 6/2W-17J(1)  
COUNTY Marion  
APPLICATION NO. GR-1817

GR 1758

OWNER: J. W. Spitler


MAILING ADDRESS: Rt. 1, Box 66 1/2

LOCATION OF WELL: Owner's No. #1

CITY AND STATE: Brooks, Oregon

NE 1/4 SE 1/4 Sec. 17 T. 6 S., R. 2 W., W.M.

Bearing and distance from section or subdivision  
corner 1100' W. & 2250' N. from SE cor. Sec. 17

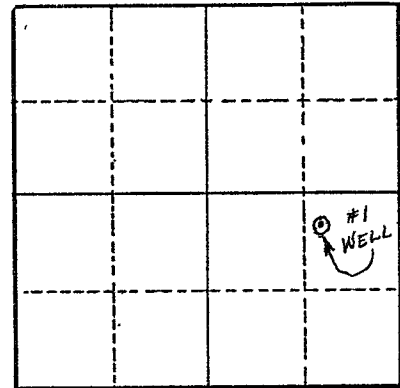

Section 17

Altitude at well 182

TYPE OF WELL: Drilled Date Constructed 1953

Depth drilled 91' Depth cased 91'

CASING RECORD:  
6"

FINISH:

AQUIFERS:

Gravel

WATER LEVEL:

20'

PUMPING EQUIPMENT: Type F. M. Jet H.P. 1  
Capacity 400 G.P.M.

WELL TESTS:

Drawdown ft. after hours G.P.M.  
Drawdown ft. after hours G.P.M.

USE OF WATER Irrigation Temp. °F., 19

SOURCE OF INFORMATION GR Record

DRILLER or DIGGER Wynore Well Drillers

ADDITIONAL DATA:

Log N.A. Water Level Measurements Chemical Analysis Aquifer Test

REMARKS:

Log: Strata consists of clay, sand & gravel.

Irrigation of 1 acre.