

STATE ENGINEER
Salem, Oregon

MARI. 4/173

Well Record

STATE WELL NO. 6/2W-17R(1)
COUNTY Marion
APPLICATION NO. GR-1045

GR- 1007

OWNER: E. W. Brutha

MAILING

ADDRESS: Rt. 1, Box 65 C

LOCATION OF WELL: Owner's No. #1


CITY AND

STATE: Brooks, Oregon

SE 1/4 SE 1/4 Sec. 17 T. 6 S., R. 2 W., W.M.

Bearing and distance from section or subdivision

corner 800' N. & 200' W. from SE cor. Sec. 17.

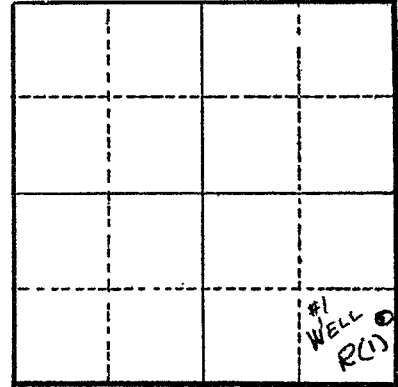

Section 17

Altitude at well 176 ft.

TYPE OF WELL: Drilled Date Constructed 1938

Depth drilled 85 ft. Depth cased 85 ft.

CASING RECORD:

6 inch

FINISH:

AQUIFERS:

WATER LEVEL:

16 ft.

PUMPING EQUIPMENT: Type F. M. Jet

H.P. 5

Capacity 75 G.P.M.

WELL TESTS:

Drawdown 28 ft. after 50 hours G.P.M.

Drawdown ft. after hours G.P.M.

USE OF WATER Irrigation Temp. °F., 19

SOURCE OF INFORMATION G.R. Record

DRILLER or DIGGER Sneed Bros.

ADDITIONAL DATA:

Log N.A. Water Level Measurements Chemical Analysis Aquifer Test

REMARKS:

Irrigation of 10 acres.