

STATE ENGINEER
Salem, Oregon

91574
MAR 11 1948

Well Record

STATE WELL NO. 6/2W-17B (2)
COUNTY Marion
APPLICATION NO. GR-1760

GR- 1705

OWNER: Wm. S. & Ruth D. Morrison


MAILING ADDRESS: Rt. 1, Box 65

LOCATION OF WELL: Owner's No. #1

CITY AND STATE: Brooks, Oregon

SE 1/4 SE 1/4 Sec. 17 T. 6 S., R. 2 W., W.M.

Bearing and distance from section or subdivision corner 670' W. & 860' N. from SE cor. Sec. 17

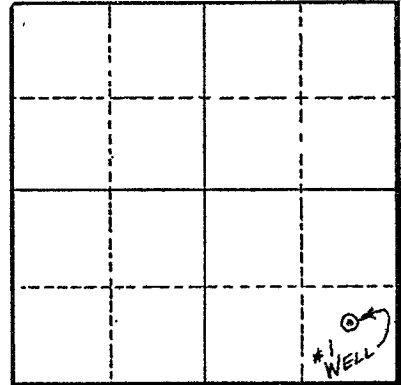

Section 17

Altitude at well 180'

TYPE OF WELL: Drilled Date Constructed 1948

Depth drilled 90' Depth cased 90'

CASING RECORD:
10"

FINISH:
?

AQUIFERS:

WATER LEVEL:
16'

PUMPING EQUIPMENT: Type F. M. Cent. H.P. 7 1/2
Capacity 225 G.P.M.

WELL TESTS:
Drawdown ft. after hours G.P.M.
Drawdown ft. after hours G.P.M.

USE OF WATER Irrigation Temp. °F. 19

SOURCE OF INFORMATION GR Record

DRILLER or DIGGER Studebaker Bros.

ADDITIONAL DATA:

Log N.A. Water Level Measurements Chemical Analysis Aquifer Test

REMARKS:

Irrigation of 20 acres.