

STATE ENGINEER
Salem, Oregon

MAR 42 1952

Well Record

STATE WELL NO. 6/2W-18E(1)
COUNTY Marion
APPLICATION NO. GR-1178

GR- 1139

OWNER: Henry Greber

MAILING

ADDRESS: Rt. 1, Box 8

LOCATION OF WELL: Owner's No.


CITY AND

STATE: Brooks, Oregon

SW 1/4 NW 1/4 Sec. 18 T. 6 S., R. 2 W., W.M.

Bearing and distance from section or subdivision

corner 15 ch. E. & 3 1/2 ch. N. from W 1/4 cor. Sec. 18.

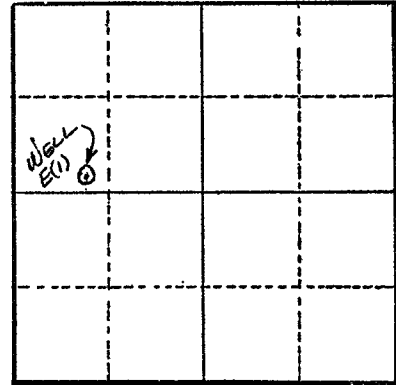

Section 18

Altitude at well 178 ft. 3 181'

TYPE OF WELL: Drilled Date Constructed 1952

Depth drilled 106 ft. Depth cased 106 ft.

CASING RECORD:

8 inch

FINISH:

AQUIFERS:

WATER LEVEL:

25 ft.

PUMPING EQUIPMENT: Type Universal turbine H.P. 5

Capacity G.P.M.

WELL TESTS:

Drawdown ft. after hours G.P.M.

Drawdown ft. after hours G.P.M.

USE OF WATER Irrigation Temp. °F., 19

SOURCE OF INFORMATION G. R. Record

DRILLER or DIGGER

ADDITIONAL DATA:

Log N.A. Water Level Measurements Chemical Analysis Aquifer Test

REMARKS:

Irrigation of 30 acres.