

STATE ENGINEER
Salem, Oregon

MAR 19 4219

Well Record

STATE WELL NO. 6/2W-18J
COUNTY MARION
APPLICATION NO. GR-2816

OWNER: William W. Cottew MAILING ADDRESS: P. O. Box 3,

LOCATION OF WELL: Owner's No. _____ CITY AND STATE: Brook, Oregon


NE 1/4 SE 1/4 Sec. 18 T. 6 ~~N.~~ S., R. 2 ~~E.~~ W., W.M.

Bearing and distance from section or subdivision corner 100' W. and 150' S.

Altitude at well 184'

TYPE OF WELL: drilled Date Constructed 1954

Depth drilled 96 Depth cased 96

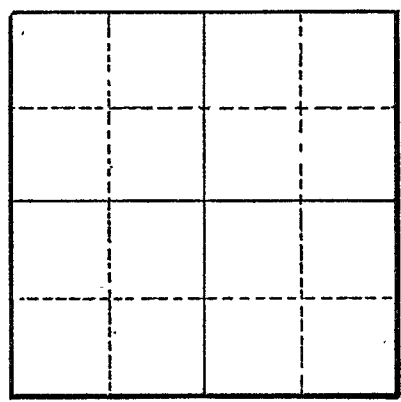

Section _____

CASING RECORD:

6-inch

FINISH:

AQUIFERS:

Topsoil, shale, sand and gravel 85' to 96'

WATER LEVEL:

20-feet 7/12/60

PUMPING EQUIPMENT: Type Fairbanks Morse Jet H.P. 1/3
Capacity 25 G.P.M.

WELL TESTS:

Drawdown 5 ft. after _____ hours Pumping 30 G.P.M.
Drawdown _____ ft. after _____ hours _____ G.P.M.

USE OF WATER irrigation Temp. _____ °F. _____, 19____

SOURCE OF INFORMATION GR-2657

DRILLER or DIGGER _____

ADDITIONAL DATA:

Log X Water Level Measurements _____ Chemical Analysis _____ Aquifer Test _____

REMARKS:

Topsoil	0	2
yellow shale	2	16
yellow silty shale	16	36
blue shale	36	57
blue silty shale	57	78
black sand	78	85
sand and gravel	85	96

