

STATE ENGINEER
Salem, Oregon

Well Record

STATE WELL NO. 6/2W-18K1
COUNTY MARION
APPLICATION NO. GR-2812

OWNER: Leon R. Deffenbaugh


MAILING ADDRESS: Brooks, Oregon

LOCATION OF WELL: Owner's No. _____

CITY AND STATE: _____

NW 1/4 SE 1/4 Sec. 18 T. 6 N. 2 E. S., R. W., W.M.

Bearing and distance from section or subdivision corner 4 chains S. and 21.5 chains W.

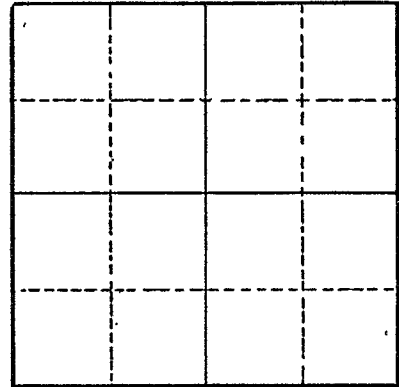

Section _____

Altitude at well 184'

TYPE OF WELL: drilled Date Constructed 1952

Depth drilled 115 Depth cased 115

CASING RECORD:

10-inch

FINISH:

Mills perforator from 90 to 115

AQUIFERS:

Topsoil, clay, gravel and sand

WATER LEVEL:

30-feet

PUMPING EQUIPMENT: Type Motor Jet H.P. 5
Capacity 50 G.P.M.

WELL TESTS:

Drawdown 29 ft. after _____ hours Pumping 220 G.P.M.
Drawdown 58 ft. after _____ hours Pumping 440 G.P.M.

USE OF WATER irrigation Temp. _____ °F., 19

SOURCE OF INFORMATION GR-2653

DRILLER or DIGGER Roy Perkins, Rt. 2, Box 315, Salem, Oregon

ADDITIONAL DATA:

Log Water Level Measurements _____ Chemical Analysis _____ Aquifer Test _____

REMARKS:

Topsoil and yellow clay 0 36
mostly gray and blue clay 36 60
Black sand and small amount of small gravel 60 85
black and blue clay 85 93
black sand and gravel 93 100
blue clay 100 104
black sand and gravel 104 115

