

STATE ENGINEER  
Salem, Oregon

4237  
MARION.....

# Well Record

GR- 1691

STATE WELL NO. 6/2W-19E (2)  
COUNTY Marion  
APPLICATION NO. GR- 1744

OWNER: Bernard F. Schreiner


MAILING ADDRESS: Rt. 2, Box 297

LOCATION OF WELL: Owner's No. #2

CITY AND STATE: Salem, Oregon

SW 1/4 NW 1/4 Sec. 19 T. 6 S., R. 2 W., W.M.

Bearing and distance from section or subdivision corner 750' E. & 2350' S. from NW cor. Sec. 19

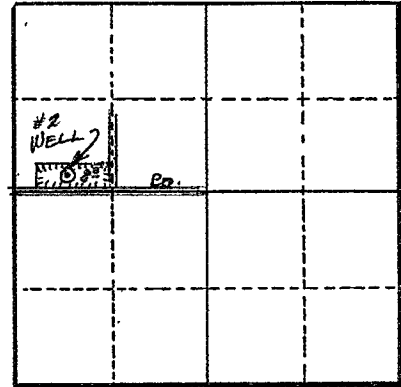

Section 19

Altitude at well 185'

TYPE OF WELL: Drilled Date Constructed 1949

Depth drilled 110' Depth cased 110'

CASING RECORD:  
8"

### FINISH:

Perforated with 1/4" x 1 1/4" slots (5/1 1/2') from 98 to 110 ft.

### AQUIFERS:

### WATER LEVEL:

32' (2 - - 49)

PUMPING EQUIPMENT: Type Jacuzzi jet H.P. 5

Capacity 150 G.P.M.

### WELL TESTS:

Drawdown 30 ft. after 200 hours G.P.M.

Drawdown ft. after hours G.P.M.

USE OF WATER Irrigation Temp. °F. 19

SOURCE OF INFORMATION GR Record

DRILLER or DIGGER Wymore

### ADDITIONAL DATA:

Log N.A. Water Level Measurements Chemical Analysis Aquifer Test

### REMARKS:

Irrigation of 8 acres.