

STATE ENGINEER  
Salem, Oregon

MAR. 4241 Well Record

STATE WELL NO. 6/2W-19D  
COUNTY MARION  
APPLICATION NO. GR-2886

OWNER: Franke Brothers & Arthur Franke Sr Mailing ADDRESS: Rt. 2, Box 223 Pg 1 of 2

LOCATION OF WELL: Owner's No. CITY AND STATE: Salem, Oregon

NW 1/4 NW 1/4 Sec. 19 T. 6 N. 2 E. S. R. W., W.M.

Bearing and distance from section or subdivision corner 370' N. and 550' E.


Altitude at well

TYPE OF WELL: drilled Date Constructed 1952

Depth drilled 81 Depth cased

Section

CASING RECORD:

FINISH:

AQUIFERS:

WATER LEVEL: 25-feet

PUMPING EQUIPMENT: Type Berkeley Turbine H.P. 25  
Capacity 560 G.P.M.

WELL TESTS:  
Drawdown 10 ft. after Pumping 300 G.P.M.  
Drawdown ft. after hours G.P.M.

USE OF WATER irrigation Temp. °F. 10

SOURCE OF INFORMATION GR-2715 utility #

DRILLER or DIGGER J. A. Sneed & Sons, 2505 Brooks, Oregon

ADDITIONAL DATA:

Log Water Level Measurements Chemical Analysis Aquifer Test

REMARKS:

STATE ENGINEER  
Salem, Oregon

**4241 Well Record**  
MAR 1952

STATE WELL NO. 6/2W-19D(1)  
COUNTY Marion  
APPLICATION NO.

pg 2 of 2

OWNER: Franke Bros.


MAILING ADDRESS:

LOCATION OF WELL: Owner's No.

CITY AND STATE:

..... 1/4 ..... 1/4 Sec. .... T. .... N. S., R. .... E. W., W.M.

Bearing and distance from section or subdivision corner

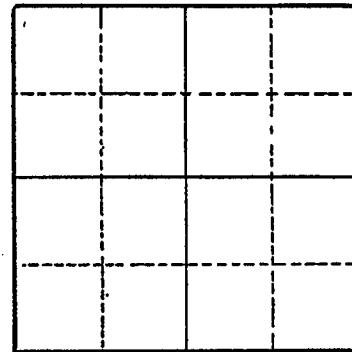

Section .....

Altitude at well 180

TYPE OF WELL: Drilled Date Constructed 1952

Depth drilled 81 Depth cased

CASING RECORD:

8 inch

FINISH:

AQUIFERS:

WATER LEVEL:

25 feet below land surface, October, 1952

PUMPING EQUIPMENT: Type Turbine H.P. 25  
Capacity G.P.M.

WELL TESTS:

Drawdown ft. after hours G.P.M.

Drawdown ft. after hours G.P.M.

USE OF WATER Irrigation--232.8 acres Temp. °F. 19

SOURCE OF INFORMATION USGS

DRILLER or DIGGER

ADDITIONAL DATA:

Log Water Level Measurements Chemical Analysis Aquifer Test

REMARKS: