

STATE ENGINEER  
- Salem, Oregon

4245  
MARION Well Record

STATE WELL NO. 6/2W-19K  
COUNTY Marion  
APPLICATION NO. GR-3472 ✓

OWNER: John Johnson Kabatoff

MAILING ADDRESS: Route 2, Box 311


pg 1 of 3

LOCATION OF WELL: Owner's No.

CITY AND STATE: Salem, Oregon

NW 1/4 SE 1/4 Sec. 19 T. 6 N. S. R. 2 W., W.M.

Bearing and distance from section or subdivision corner 6 chains E. and 4 chains S.

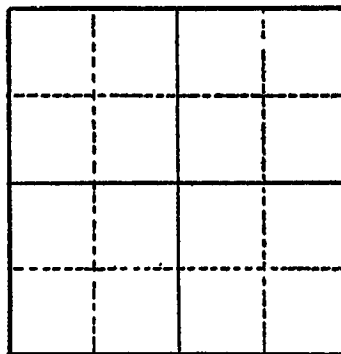

Section .....

Altitude at well .....

TYPE OF WELL: drilled Date Constructed 1950

Depth drilled 93' Depth cased 93'

CASING RECORD:

8"

FINISH:

1/4" wide, 4" long, 5 to the foot perforations from 81 to 93

AQUIFERS:

topsoil, clay, sand, gravel

WATER LEVEL:

55'

PUMPING EQUIPMENT: Type Jacuzzi Turbine H.P. 10

Capacity G.P.M.

WELL TESTS:

Drawdown 35 ft. after hours pumping 425 G.P.M.

Drawdown ft. after hours G.P.M.

USE OF WATER Irrigation Temp. °F., 19

SOURCE OF INFORMATION GR-3209

DRILLER or DIGGER

ADDITIONAL DATA:

Log  Water Level Measurements Chemical Analysis Aquifer Test

REMARKS:

Topsoil	0	3
Yellow clay	3	38
Yellow sand	38	43
Blue clay	43	78
Water, sand and gravel	78	93

STATE ENGINEER  
Salem, Oregon

**MARI. 4245 Well Record**

STATE WELL NO. 6/2W-19K(1)  
COUNTY Marion  
APPLICATION NO. \_\_\_\_\_

Pg 2 of 3

OWNER: J. J. Kabatoff

MAILING ADDRESS: \_\_\_\_\_

LOCATION OF WELL: Owner's No. \_\_\_\_\_

CITY AND STATE: \_\_\_\_\_

\_\_\_\_\_  $\frac{1}{4}$  \_\_\_\_\_  $\frac{1}{4}$  Sec. \_\_\_\_\_ T. \_\_\_\_\_ N. \_\_\_\_\_ E. \_\_\_\_\_ S., R. \_\_\_\_\_ W., W.M.

Bearing and distance from section or subdivision corner \_\_\_\_\_

Altitude at well 182

TYPE OF WELL: Drilled Date Constructed 1950

Depth drilled 93 Depth cased 93


Section \_\_\_\_\_

**CASING RECORD:**

8 inch

**FINISH:**

Casing perforated 81 to 93

**AQUIFERS:**

Sand and gravel from 78 to 93

**WATER LEVEL:**

55 feet below land surface, August, 1950

PUMPING EQUIPMENT: Type Turbine H.P. 10  
Capacity \_\_\_\_\_ G.P.M.

**WELL TESTS:**

Drawdown \_\_\_\_\_ ft. after \_\_\_\_\_ hours \_\_\_\_\_ G.P.M.

Drawdown \_\_\_\_\_ ft. after \_\_\_\_\_ hours \_\_\_\_\_ G.P.M.

USE OF WATER Irrigation--9 acres Temp. \_\_\_\_\_ °F. \_\_\_\_\_, 19\_\_\_\_

SOURCE OF INFORMATION USGS

DRILLER or DIGGER \_\_\_\_\_

**ADDITIONAL DATA:**

Log  Water Level Measurements \_\_\_\_\_ Chemical Analysis \_\_\_\_\_ Aquifer Test \_\_\_\_\_

**REMARKS:**

