

STATE ENGINEER
Salem, Oregon

4266 Well Record
MAR...66

STATE WELL NO. 6/2W-20M
COUNTY Marion
APPLICATION NO. GR-3112

OWNER: Knight Pearcy


MAILING ADDRESS: P.O. Box 12

LOCATION OF WELL: Owner's No. #2

CITY AND STATE: Salem, Oregon

NW 1/4 SW 1/4 Sec. 20 T. 6 S., R. 2 W., W.M.

Bearing and distance from section or subdivision corner 1020' W. and 370' S.

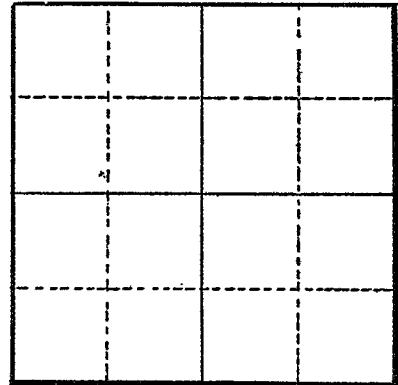

Section

Altitude at well

TYPE OF WELL: drilled Date Constructed 1940

Depth drilled 92' Depth cased

CASING RECORD:

6"

FINISH:

probably not perforated

AQUIFERS:

WATER LEVEL:

28'

PUMPING EQUIPMENT: Type Jet H.P. 3
Capacity 35 G.P.M.

WELL TESTS:

Drawdown ft. after hours pumping 30 G.P.M.
Drawdown ft. after hours G.P.M.

USE OF WATER Irrigation Temp. °F., 19

SOURCE OF INFORMATION GR-2920

DRILLER or DIGGER Sneed and Son Salem, Oregon

ADDITIONAL DATA:

Log Water Level Measurements Chemical Analysis Aquifer Test

REMARKS: