

STATE ENGINEER  
Salem, Oregon

MAR 1940

# Well Record

STATE WELL NO. 6/2W-20R(1)  
COUNTY Marion  
APPLICATION NO. GR-193

OWNER: J. W. Fitts


MAILING ADDRESS:

LOCATION OF WELL: Owner's No. #3

CITY AND STATE: Brooks, Oregon

SE 1/4 SE 1/4 Sec. 20 T. 6 S., R. 2 W., W.M.

Bearing and distance from section or subdivision corner N. 57° 46' E. 3526.09' from the NE Cor. Sanford Stephens D.L.C.

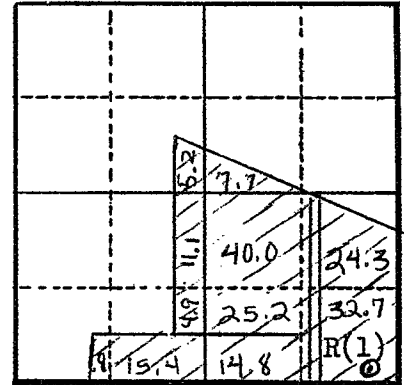

Altitude at well 160' Interpolated

Section

TYPE OF WELL: Drilled Date Constructed 9/1/40

Depth drilled 73' Depth cased

### CASING RECORD:

10" casing set from 0 to 73'

### FINISH:

10 perforations (1/4" X 8") from 53 to 73'

### AQUIFERS:

No record Gravel

### WATER LEVEL:

15' below land surface Sept. 1940 13.35' (1-15-60)

PUMPING EQUIPMENT: Type Deming Turbine H.P. Tractor motor

Capacity 700 G.P.M.

### WELL TESTS:

Drawdown 40 ft. after hours Pumping 750 G.P.M.

Drawdown ft. after hours G.P.M.

USE OF WATER Irrigation 155.3 acres Temp. °F., 19

SOURCE OF INFORMATION Registration Statement GR-193

DRILLER or DIGGER

### ADDITIONAL DATA:

Log X Water Level Measurements Chemical Analysis Aquifer Test

REMARKS: This is one of a three well system.