

STATE ENGINEER
Salem, Oregon

4272
MARI.....

Well Record

STATE WELL NO. 6/2W-20K(1)
COUNTY Marion
APPLICATION NO. GR-193

OWNER: J. W. Fitts


MAILING ADDRESS:

LOCATION OF WELL: Owner's No. #4

CITY AND STATE: Brooks, Oregon

NW 1/4 SE 1/4 Sec. 20 T. 6 S. R. W., W.M.

Bearing and distance from section or subdivision
corner N. 20° 7' E. 3674.92' from NE Corner
Sanford Stephens D.L.C.

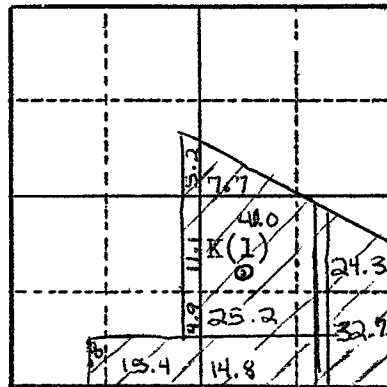

Section 20

Altitude at well 160' Interpolated

TYPE OF WELL: Drilled Date Constructed 3/20/54

Depth drilled 190' Depth cased 190'

CASING RECORD:

10" casing set from 0 to 190'

FINISH:

Unknown

AQUIFERS:

No record

WATER LEVEL:

22' below land surface 4/1/54

PUMPING EQUIPMENT: Type Fairbanks-Morse 10 stage turbine H.P. tractor moto
Capacity 700 G.P.M.

WELL TESTS:

Drawdown 16 ft. after hours pumping 500 G.P.M.

Drawdown ft. after hours G.P.M.

USE OF WATER Irrigation 106.7 acres Temp. °F., 19

SOURCE OF INFORMATION Registration Statement Gr-193

DRILLER or DIGGER

ADDITIONAL DATA:

Log No Water Level Measurements Chemical Analysis Aquifer Test

REMARKS: