

STATE ENGINEER
Salem, Oregon

MARI... 4317

Well Record

STATE WELL NO. 6/2W - 21J
COUNTY Marion
APPLICATION NO. GR-856


OWNER: Labish Center Farms, Inc.
W. Douglas Harris, Sec.

MAILING ADDRESS: _____

LOCATION OF WELL: Owner's No. #1

CITY AND STATE: Brooks

NE 1/4 SE 1/4 Sec. 21 T. 6 S., R. 2 W., W.M.

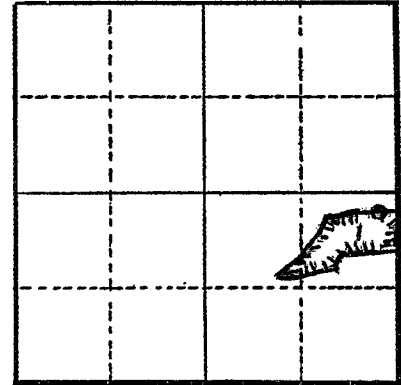

Bearing and distance from section or subdivision corner 110' S & 300' W E₁ cor. Sec. 21

Section 21

Altitude at well 135

TYPE OF WELL: drilled Date Constructed April, 1947

Depth drilled 60' Depth cased 60'

CASING RECORD:

8" steel 0' - 60'

FINISH:

Open End

AQUIFERS:

Loose Gravel 45' - 60'

WATER LEVEL:

2 (4- -42)

PUMPING EQUIPMENT: Type Jacuzzi Centrifugal H.P. 5 Electric
Capacity 250 G.P.M.

WELL TESTS:

Drawdown 8 ft. after 250 hours G.P.M.

Drawdown _____ ft. after _____ hours G.P.M.

USE OF WATER Irrigation - 21 acres Temp. °F., 19

SOURCE OF INFORMATION _____

DRILLER or DIGGER Ralph Stadeli

ADDITIONAL DATA:

Log Water Level Measurements _____ Chemical Analysis _____ Aquifer Test _____

REMARKS:

Log: Dirt and loam 0 - 45'
Loose gravel 45' - 60'