

STATE ENGINEER
Salem, Oregon

4323
MARI.....

Well Record

GR- 1674

STATE WELL NO. 6/2W-21C(1)
COUNTY Marion
APPLICATION NO. GR- 1725

OWNER: Walter F. Busch


MAILING ADDRESS: Rt. 1, Box 234

LOCATION OF WELL: Owner's No.

CITY AND STATE: Brooks, Oregon

NE 1/4 NW 1/4 Sec. 21 T. 6 S, R. 2 W., W.M.

Bearing and distance from section or subdivision corner 800' S. & 50' W. from N 1/4 cor. Sec. 21

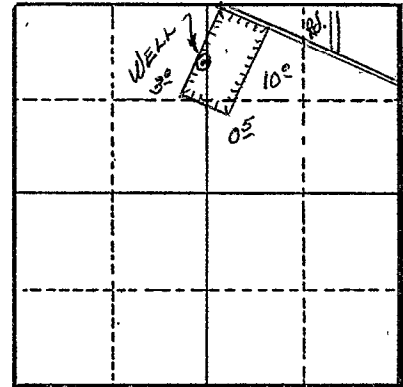

Section 21

Altitude at well 160'

TYPE OF WELL: Drilled Date Constructed 1946

Depth drilled 68' Depth cased 68'

CASING RECORD:
8"

FINISH:
?

AQUIFERS:

WATER LEVEL:
6-8 ft. - flows in the winter

PUMPING EQUIPMENT: Type Cent. H.P. 9
Capacity G.P.M.

WELL TESTS:
Drawdown 4 ft. after 160 hours G.P.M.
Drawdown ft. after hours G.P.M.

USE OF WATER Irrigation Temp. °F. 19

SOURCE OF INFORMATION GR Record

DRILLER or DIGGER Wymore

ADDITIONAL DATA:
Log N.A. Water Level Measurements Chemical Analysis Aquifer Test

REMARKS:

Irrigation of 13.5 acres.