

STATE ENGINEER
Salem, Oregon

MAR 1 4:32 PM 1948

Well Record

STATE WELL NO. 6/2W-21H
COUNTY MARION
APPLICATION NO. GR-2346

OWNER: Marshall Christofferson


MAILING ADDRESS: Rt. 1, Box 237-C

LOCATION OF WELL: Owner's No.

CITY AND STATE: Brooks, Oregon

SE 1/4 NE 1/4 Sec. 21 T. 6 N. S., R. 2 E. W., W.M.

Bearing and distance from section or subdivision corner 1150' W. and 2450' S.

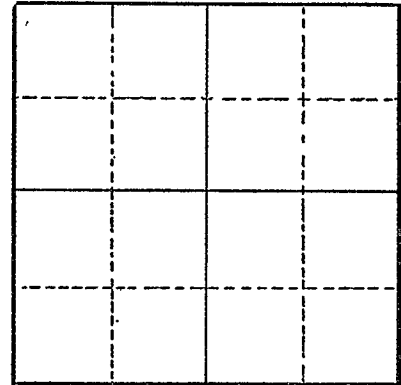

Section

Altitude at well 155'

TYPE OF WELL: Drilled Date Constructed 1948

Depth drilled 64 Depth cased 62

CASING RECORD:

10-inch

FINISH:

8' perforated section of pipe from 63 to 55
1 1/2" perforations

AQUIFERS:

Soil, shale and sand

WATER LEVEL:

8-feet

PUMPING EQUIPMENT: Type Crysler Marine Industrial H.P. 30
Capacity 700 G.P.M.

WELL TESTS:

Drawdown 18 ft. after hours Pumping 500 G.P.M.
Drawdown ft. after hours G.P.M.

USE OF WATER Irrigation - 28 acres Temp. °F., 19

SOURCE OF INFORMATION GR-2229

DRILLER or DIGGER Fred Wymore Rt. 2, Salem, Oregon

ADDITIONAL DATA:

Log Water Level Measurements Chemical Analysis Aquifer Test

REMARKS:

Top soil 0 - 3
Subsoil - yellow shale 3 - 28
Blue shale 28 - 41
Gravel & Sand 41 - 64