

STATE ENGINEER
Salem, Oregon

MAK 4.325

Well Record

STATE WELL NO. 6/2W-21 M (1)
COUNTY Marion
APPLICATION NO. GR-193

OWNER: J. W. Fitts


MAILING ADDRESS:

LOCATION OF WELL: Owner's No. #1

CITY AND STATE: Brooks, Oregon

NW 1/4 SW 1/4 Sec. 21 T. 6 S., R. 2 W., W.M.

Bearing and distance from section or subdivision corner N 54° 19' E 5544.20 feet from NE corner Sanford Stephens D.L.C.

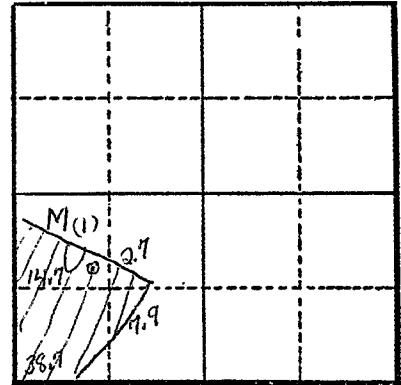

Section 21

Altitude at well 160 feet Interpolated

TYPE OF WELL: Bored Date Constructed 5/15/42

Depth drilled 48' Depth cased 48'

CASING RECORD:

24-inch casing set from 0 to 48 feet

FINISH:

20 perforations per foot. (1" diameter) from 43 to 48 feet

AQUIFERS:

No record

WATER LEVEL:

3 feet below land surface. 8/1/56

PUMPING EQUIPMENT: Type Turbine H.P. 20
Capacity 400 G.P.M.

WELL TESTS:

Drawdown 36 ft. after hours pumping 300 G.P.M.
Drawdown ft. after hours G.P.M.

USE OF WATER Irrigation 155.30 acres Temp. °F., 19

SOURCE OF INFORMATION Registration Statement GR-179

DRILLER or DIGGER Fred Wymore Canby, Oregon

ADDITIONAL DATA:

Log No Water Level Measurements Chemical Analysis Aquifer Test

REMARKS:

This is one of a system of 3 wells (#1-2-3)

Flows in winter and spring.