

STATE ENGINEER
Salem, Oregon

4326
MAR 1943

Well Record

STATE WELL NO. 6/2W-21 N (1)
COUNTY Marion
APPLICATION NO. GR-193

OWNER: J. W. Fitts

MAILING ADDRESS: _____


LOCATION OF WELL: Owner's No. #2

CITY AND STATE: Brooks, Oregon

SW 1/4 SW 1/4 Sec. 21 T. 6 S., R. 2 W., W.M.

Bearing and distance from section or subdivision corner N 64° 33' E 4748.52 feet from NE corner

Sanford Stephens D.L.C.

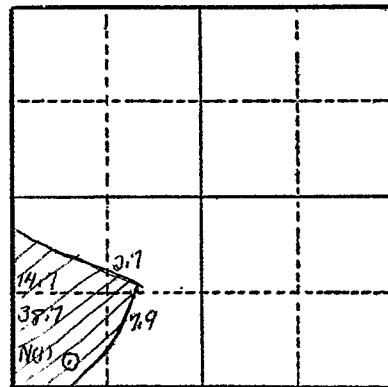

Section 21

Altitude at well 160 feet Interpolated

TYPE OF WELL: Drilled Date Constructed 3/15/43

Depth drilled 60' Depth cased 60'

CASING RECORD:

8-inch casing set from 0 to 60 feet.

FINISH:

4 perforations/foot (1/2"x6") from 0 to 60 feet.

AQUIFERS:

No record

WATER LEVEL:

2 feet below land surface. 7/1/56

PUMPING EQUIPMENT: Type Centrifugal H.P. 15
Capacity 300 G.P.M.

WELL TESTS:

Drawdown 2 ft. after _____ hours pumping 300 G.P.M.

Drawdown _____ ft. after _____ hours _____ G.P.M.

USE OF WATER Irrigation 155.3 acres Temp. _____ °F., 19

SOURCE OF INFORMATION Registration Statement GR-179

DRILLER or DIGGER Fred Wymore

ADDITIONAL DATA:

Log No. _____ Water Level Measurements _____ Chemical Analysis _____ Aquifer Test _____

REMARKS:

This is one of three wells in system.