

STATE ENGINEER
Salem, Oregon

4373
MARI...

Well Record

STATE WELL NO. 6/2W-22E (1)
COUNTY Marion
APPLICATION NO. GR- 1678

GR- 1627

OWNER: Stanley A. Brown


MAILING ADDRESS: Rt. 1, Box 181B

LOCATION OF WELL: Owner's No.

CITY AND STATE: Brooks, Oregon

SW 1/4 NW 1/4 Sec. 22 T. 6 S., R. 2 W., W.M.

Bearing and distance from section or subdivision corner 1600' S. & 325' E. from NW cor. Sec. 22

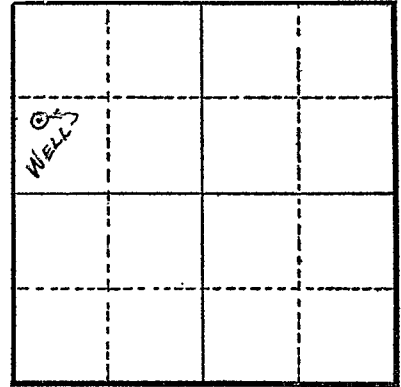

Section 22

Altitude at well 140'

TYPE OF WELL: Drilled Date Constructed 1942

Depth drilled 52' Depth cased 52'

CASING RECORD:
10"

FINISH:

AQUIFERS:

Gravel from 32 to 52

WATER LEVEL:
4'

PUMPING EQUIPMENT: Type Cent. H.P. 10
Capacity 350 G.P.M.

WELL TESTS:
Drawdown 8 ft. after 300 hours G.P.M.
Drawdown ft. after hours G.P.M.

USE OF WATER Irrigation Temp. °F., 19

SOURCE OF INFORMATION GR Record

DRILLER or DIGGER

ADDITIONAL DATA:

Log Water Level Measurements Chemical Analysis Aquifer Test

REMARKS:

Log: Willamette loam 0 to 32 ft.
Santiam gravel 32 to 52 ft.

Irrigation of 13.25 acres.