

STATE ENGINEER  
Salem, Oregon

4375  
MARION

# Well Record

STATE WELL NO. 6/2W-22F (1)  
COUNTY Marion  
APPLICATION NO. GR-1563

GR- 1506

OWNER: H. B. & W. B. Aker

MAILING  
ADDRESS:

Rt. 1, Box 228


LOCATION OF WELL: Owner's No.

CITY AND  
STATE:

Brooks, Oregon

SE  $\frac{1}{4}$  NW  $\frac{1}{4}$  Sec. 22 T. 6 S., R. 2 W., W.M.

Bearing and distance from section or subdivision  
corner 1780' E. & 1900' S. from NW cor. Sec. 22

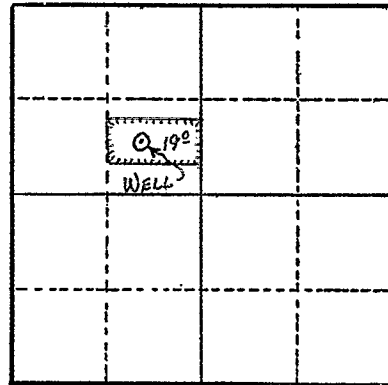

Section 22

Altitude at well 125' 3 135'

TYPE OF WELL: Drilled Date Constructed 1942

Depth drilled 65' Depth cased 65'

### CASING RECORD:

8"

### FINISH:

### AQUIFERS:

### WATER LEVEL:

1'  $\frac{1}{2}$  ft. - flows during winter months when wet

PUMPING EQUIPMENT: Type Goulds 2" x 2" Cent. H.P. 5  
Capacity 145 G.P.M.

### WELL TESTS:

Drawdown 4 ft. after hours 144 G.P.M.

Drawdown ft. after hours G.P.M.

USE OF WATER Irrigation Temp. °F., 19

SOURCE OF INFORMATION GR- Record

DRILLER or DIGGER

### ADDITIONAL DATA:

Log N.A. Water Level Measurements Chemical Analysis Aquifer Test

### REMARKS:

Materials consist of mostly clay & gravel

Irrigation of 19 acres.