

STATE ENGINEER
Salem, Oregon

438
MARION

Well Record

STATE WELL NO. 6/2W - 22N (1)
COUNTY MARION
APPLICATION NO. GR-1996

OWNER: O. G. Mc Claghry


MAILING ADDRESS: Rt. 2, Box 454

LOCATION OF WELL: Owner's No. _____

CITY AND STATE: Salem, Oregon

SW $\frac{1}{4}$ SW $\frac{1}{4}$ Sec. 22 T. 6 N. S., R. 2 W., W.M.

Bearing and distance from section or subdivision corner 1020' N. & 350' E.

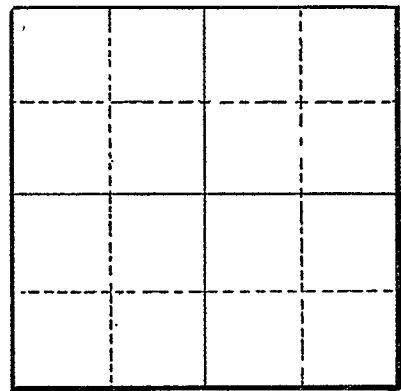

Altitude at well 148'

TYPE OF WELL: Drilled Date Constructed 1940

Depth drilled 112 Depth cased 112

Section _____

CASING RECORD:

12-inch

FINISH:

Perforation from 0 to 20

AQUIFERS:

GRAVEL

WATER LEVEL:

6-feet

PUMPING EQUIPMENT: Type Fairbanks Morse H.P. 5

Capacity 135 G.P.M.

WELL TESTS:

Drawdown 31 ft. after _____ hours Pumping 135 G.P.M.

Drawdown _____ ft. after _____ hours _____ G.P.M.

USE OF WATER Irrigation - 34 acres Temp. _____ °F. _____, 19____

SOURCE OF INFORMATION GR-1926

DRILLER or DIGGER Stadley

ADDITIONAL DATA:

Log Water Level Measurements _____ Chemical Analysis _____ Aquifer Test _____

REMARKS:

Water Bearing Gravel at 92 feet depth.