

STATE ENGINEER  
Salem, Oregon

4396  
MARI.....

# Well Record

STATE WELL NO. 6/27-23D  
COUNTY Marion  
APPLICATION NO. GR-3728

OWNER: E. M. Boies


MAILING ADDRESS: Route 1, Box 181 Pg 1 of 2

LOCATION OF WELL: Owner's No.

CITY AND STATE: Brooks, Oregon

NW 1/4 NW 1/4 Sec. 23 T. 6 S., R. 2 W., W.M.

Bearing and distance from section or subdivision corner 20 ch. S. of NW cor. of Sec. 23

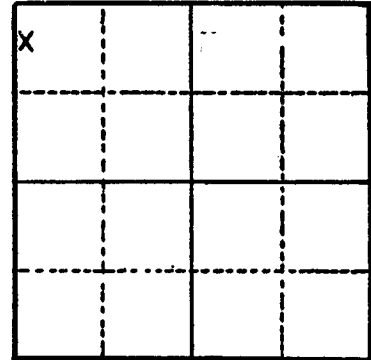

Section 23

Altitude at well

TYPE OF WELL: Drilled Date Constructed Mar., 1941

Depth drilled 139 feet Depth cased 139 feet

### CASING RECORD:

10 inch steel casing set to 139 feet

### FINISH:

Perforated from 132 to 139 feet

### AQUIFERS:

### WATER LEVEL:

10 feet below surface

PUMPING EQUIPMENT: Type Pemona H.P. 5  
Capacity 245 G.P.M.

### WELL TESTS:

Drawdown 70 ft. after 400 hours G.P.M.  
Drawdown ft. after hours G.P.M.

USE OF WATER Irrigation Temp. °F., 19

SOURCE OF INFORMATION Well Registration Statement

DRILLER or DIGGER Mr. Sloper

### ADDITIONAL DATA:

Log Water Level Measurements Chemical Analysis Aquifer Test

### REMARKS:

3402

STATE ENGINEER  
Salem, Oregon

4396  
MARI..6

# Well Record

STATE WELL NO. 6/2W-23D(1)  
COUNTY Marion  
APPLICATION NO. Pg 2 of 2

OWNER: E. M. Boles

MAILING ADDRESS:  
CITY AND STATE:

LOCATION OF WELL: Owner's No.

..... 1/4 ..... 1/4 Sec. .... T. .... N. E. S., R. .... W., W.M.

Bearing and distance from section or subdivision corner


Section .....

Altitude at well ..... 140

TYPE OF WELL: Drilled Date Constructed 1941

Depth drilled 139 ..... Depth cased 139

### CASING RECORD:

10 inch

### FINISH:

Casing perforated 132 to 139

### AQUIFERS:

### WATER LEVEL:

PUMPING EQUIPMENT: Type Turbine ..... H.P. 7 1/2  
Capacity ..... G.P.M.

### WELL TESTS:

Drawdown ..... ft. after ..... hours ..... G.P.M.  
Drawdown ..... ft. after ..... hours ..... G.P.M.

USE OF WATER Irrigation--97 acres Temp. °F. ...., 19

SOURCE OF INFORMATION USGS

DRILLER or DIGGER

### ADDITIONAL DATA:

Log ..... Water Level Measurements ..... Chemical Analysis ..... Aquifer Test .....

### REMARKS: