

STATE ENGINEER
Salem, Oregon

44-04
MARION

Well Record


STATE WELL NO. 6/24-240
COUNTY Marion
APPLICATION NO. GR-2527

OWNER: Louis Matye, Jr. MAILING ADDRESS: Rt. 2, Box 253B

LOCATION OF WELL: Owner's No. CITY AND STATE: Silverton, Oregon

SW 1/4 SE 1/4 Sec. 24 T. 6 S., R. 2 W., W.M.

Bearing and distance from section or subdivision corner 2195 ft. N. 86° 50' W. from SE Sec. 24

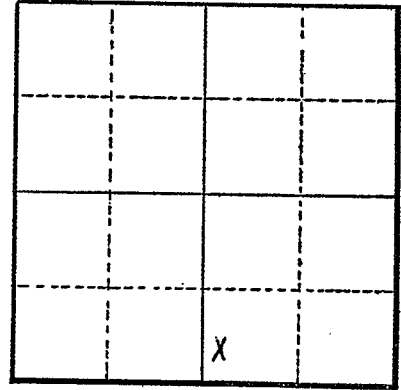

Section 24

Altitude at well

TYPE OF WELL: Drilled Date Constructed fall, 1943

Depth drilled 84 Depth cased

CASING RECORD:

FINISH:

No perforations

AQUIFERS:

WATER LEVEL:

60 feet below surface

PUMPING EQUIPMENT: Type Jacuzzi centrifugal electric H.P. 5
Capacity 40 G.P.M.

WELL TESTS:

Drawdown 10 ft. after hours G.P.M.
Drawdown 10 ft. after hours G.P.M.

USE OF WATER Irrigation Temp. °F., 19

SOURCE OF INFORMATION Well Registration Statement

DRILLER or DIGGER Ed Wymore

ADDITIONAL DATA:

Log Water Level Measurements Chemical Analysis Aquifer Test

REMARKS: