

STATE ENGINEER  
Salem, Oregon

4409  
MARI.....

# Well Record

STATE WELL NO. 6/2W-240  
COUNTY Marion  
APPLICATION NO. GR-3033

OWNER: Roy Sr. or Clara M. Dunn


MAILING ADDRESS: Route 2, Box 253

LOCATION OF WELL: Owner's No.

CITY AND STATE: Silverton, Oregon

SW 1/4 SE 1/4 Sec. 24 T. 6 N. S., R. 2 W., W.M.

Bearing and distance from section or subdivision corner 1730' N. 52° W. from the S.E. corner of Section 24

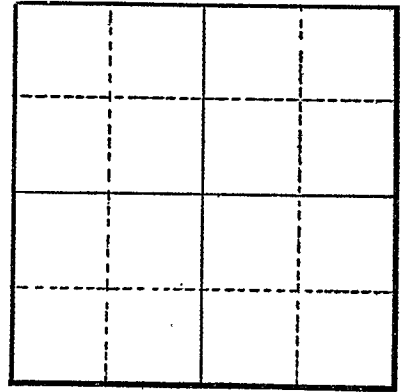

Section .....

Altitude at well

TYPE OF WELL: drilled Date Constructed 1955

Depth drilled 140 Depth cased 141

### CASING RECORD:

8 inches

### FINISH:

40 rows of eight cuts per row from 112 to 141

### AQUIFERS:

Soil, clay, shale, sand, and gravel

### WATER LEVEL:

37 feet

PUMPING EQUIPMENT: Type Jacuzzi turbine H.P. 10  
Capacity 195 G.P.M.

### WELL TESTS:

Drawdown 56 ft. after ..... hours Pumping 165 G.P.M.  
Drawdown 77 ft. after ..... hours Pumping 540 G.P.M.

USE OF WATER Irrigation Temp. °F. , 19

SOURCE OF INFORMATION GR-2841

DRILLER or DIGGER Max Wymore, Salem, Oregon

### ADDITIONAL DATA:

Log  Water Level Measurements ..... Chemical Analysis ..... Aquifer Test .....

### REMARKS:

Top soil	3	3
Brown silt and clay	35	38
Blue shale	25	63
Brown sandy shale	19	82
Brown sand	26	108
Gravel	2	110
Sand and gravel (water)	6	116
Mostly gravel (water)	24	140
Cemented gravel	1	140