

STATE ENGINEER
Salem, Oregon


4410
MAR 11 1955
Well Record

STATE WELL NO. 6/2W-24R
COUNTY Marion
APPLICATION NO. GR-3271

OWNER: Percy Dunn
MAILING ADDRESS: Rt. 2, Box 207
CITY AND STATE: Silverton, Oregon

LOCATION OF WELL: Owner's No. ^{N.} ^{E.}
SE 1/4 SE 1/4 Sec. 24 T. 6 S., R. 2 W., W.M.

Bearing and distance from section or subdivision
corner 1205' N. 23° 15' W. from SE cor. Sec. 24

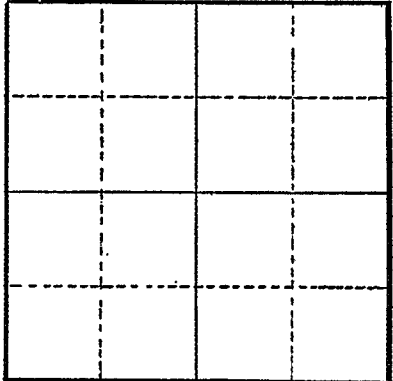

Section

Altitude at well

TYPE OF WELL: drilled Date Constructed 1955
Depth drilled 140 Depth cased 140

CASING RECORD:

8 inch

FINISH:

36 rows of 8 cuts per row mills perforator from 109 to 140

AQUIFERS:

Soil, clay, shale, sand, and gravel

WATER LEVEL:

31 feet

PUMPING EQUIPMENT: Type Jacuzzi turbine H.P. 10
Capacity 200 G.P.M.

WELL TESTS:

Drawdown 51 ft. after hours Pumping 100 G.P.M.
Drawdown 120 ft. after hours Pumping 300 G.P.M.

USE OF WATER Irrigation Temp. °F., 19

SOURCE OF INFORMATION GR-3042

DRILLER or DIGGER Willamette Drilling Co.

ADDITIONAL DATA:

Log Water Level Measurements Chemical Analysis Aquifer Test

REMARKS:

