

STATE ENGINEER
Salem, Oregon

4429
MAR. 29

Well Record


STATE WELL NO. 6/2W-24P(1)
COUNTY Marion
APPLICATION NO. GR-217

OWNER: Robert C. & Eva J. Meye
MAILING ADDRESS: Rt. 2, Box 234

LOCATION OF WELL: Owner's No. #1
CITY AND STATE: Silverton, Oregon

SE 1/4 SW 1/4 Sec. 24 T. 6 N. S. R. 2 W., W.M.

Bearing and distance from section or subdivision
corner 816.42' N. & 1393.82' E. of SW Corner of
Section #24

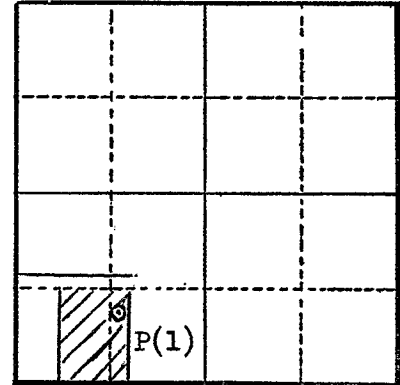

Section 24

Altitude at well 246' Interpolated

TYPE OF WELL Drilled Date Constructed 1941

Depth drilled 114 Depth cased

CASING RECORD:

8" steel casing set from 0 to 114'

FINISH:

Perforated from 80 to 114 (approximately)

AQUIFERS:

Sand & gravel from 90 to 114 feet

WATER LEVEL:

59' below land surface 1941

PUMPING EQUIPMENT: Type Pomono Turbine H.P. 7 1/2
Capacity 145 G.P.M.

WELL TESTS:

Drawdown 17 ft. after pumping 143 hours G.P.M.
Drawdown ft. after hours G.P.M.

USE OF WATER Irrigation 25.73 acres Temp. °F., 19

SOURCE OF INFORMATION Registration Statement GR-217

DRILLER or DIGGER Unknown

ADDITIONAL DATA:

Log Yes Water Level Measurements Chemical Analysis Aquifer Test

REMARKS: