

STATE ENGINEER
Salem, Oregon

MARI. 4437

Well Record

STATE WELL NO. 6/2W-25
COUNTY MARION
APPLICATION NO. GR-2578

9-1718

OWNER: Wayne N. Lovre


MAILING ADDRESS: Rt. 2, Silverton,

LOCATION OF WELL: Owner's No.

CITY AND STATE: Oregon

$N\frac{1}{2}$ $\frac{1}{4}$ SE $\frac{1}{4}$ Sec. 25 T. 6 N. S., R. 2 E. W., W.M.

Bearing and distance from section or subdivision corner 487.74' S. of $\frac{1}{4}$ Sec. line 2260' W. 199.92' S.

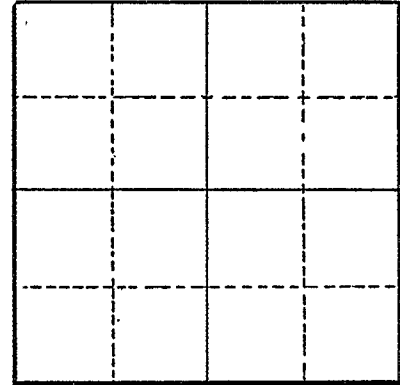

Section

Altitude at well

TYPE OF WELL: Drilled Date Constructed 1951

Depth drilled 144 Depth cased 144

CASING RECORD:

8-inch

FINISH:

Unknown from 120' to 144'

AQUIFERS:

WATER LEVEL:

38-feet

PUMPING EQUIPMENT: Type Berkeley Deep Well Turbine H.P. 10
Capacity 150 G.P.M.

WELL TESTS:

Drawdown 90 ft. after hours Pumping 150 G.P.M.
Drawdown ft. after hours G.P.M.

USE OF WATER Irrigation & Domestic Temp. °F. 19

SOURCE OF INFORMATION GR-2448

DRILLER or DIGGER Hardy Brothers, Hillsboro, Oregon

ADDITIONAL DATA:

Log Water Level Measurements Chemical Analysis Aquifer Test

REMARKS: