

STATE ENGINEER
Salem, Oregon

4447
MARI.....17

Well Record

STATE WELL NO. 6/2W-26K(1)
COUNTY Marion
APPLICATION NO. GR-122

OWNER: Ed. Haslebacher


MAILING ADDRESS: Rt. 6, Box 305

LOCATION OF WELL: Owner's No. #1

CITY AND STATE: Salem, Oregon

NW 1/4 SE 1/4 Sec. 26 T. 6 S, R. 2 W., W.M.

Bearing and distance from section or subdivision corner 1725' W. & 1375' N. of SE Cor. of Sec. 26

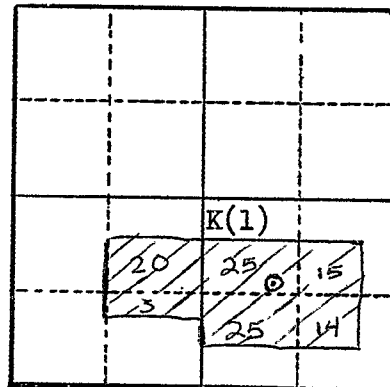

Section 26

Altitude at well 180' Interpolated

TYPE OF WELL: Drilled Date Constructed 7/29/55

Depth drilled 157 Depth cased 157

CASING RECORD:

10" steel casing set from 0 to 157' welded joints

FINISH:

3" X 3/8" perforations set 6 every 18" from 106 to 117' and 119 to 157'

AQUIFERS:

Sands and gravels between 94 and 157'

WATER LEVEL:

40' below land surface Nov. 7, 1955

PUMPING EQUIPMENT: Type Jacuzzi Turbine

H.P. 25

Capacity 320 G.P.M.

WELL TESTS:

Drawdown 39 ft. after 575 hours G.P.M.

Drawdown 9 ft. after 200 hours G.P.M.

USE OF WATER Irrigation 102 acres Temp. °F. 19

SOURCE OF INFORMATION Registration Statement GR-122

DRILLER or DIGGER

ADDITIONAL DATA:

Log X Water Level Measurements Chemical Analysis Aquifer Test

REMARKS:

