

STATE ENGINEER
Salem, Oregon

4470
MAR. Well Record

STATE WELL NO. 6/2W-27M(1)
COUNTY Marion
APPLICATION NO. GR-349

OWNER: Victor Williamson


MAILING ADDRESS: 336 Oak St.

LOCATION OF WELL: Owner's No.

CITY AND STATE: Salem, Oregon

NW 1/4 SW 1/4 Sec. 27 T. 6 S., R. 2 W., W.M.

Bearing and distance from section or subdivision corner
Appr. 850' E. & 1690' N. from SW Cor.
Sec. 27

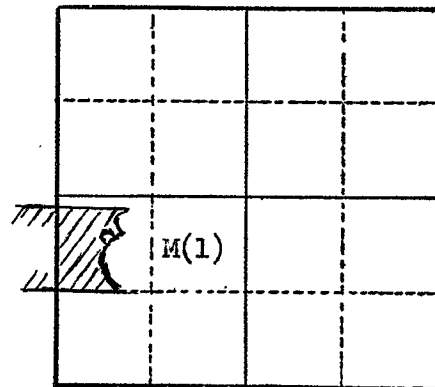

Section 27

Altitude at well 175

TYPE OF WELL: Drilled Date Constructed July 1950

Depth drilled 110 Depth cased 110

CASING RECORD:

10" +3 to 110' of 10" casing

FINISH:

Casing perforated 57-83

AQUIFERS:

WATER LEVEL:

% (7-50)

PUMPING EQUIPMENT: Type Centrifical H.P. 65
Capacity 600 G.P.M.

WELL TESTS:

Drawdown ft. after hours G.P.M.

Drawdown ft. after hours G.P.M.

USE OF WATER Irrigation 49 acres Temp. °F., 19

SOURCE OF INFORMATION Ground water registration record

DRILLER or DIGGER R. Stadeli

ADDITIONAL DATA:

Log No. Water Level Measurements Chemical Analysis Aquifer Test

REMARKS: