

STATE ENGINEER  
Salem, Oregon

4492  
MAR 11 1952

# Well Record

STATE WELL NO. 6/2W-28 H (1)  
COUNTY Marion  
APPLICATION NO. GR-254

OWNER: Darwin W. Calfee

MAILING

ADDRESS:

Route 2, Box 441

LOCATION OF WELL: Owner's No.

CITY AND

STATE:

Salem, Oregon


SE 1/4 NE 1/4 Sec. 28 T. 6 S., R. 2 W., W.M.

Bearing and distance from section or subdivision

corner 3,038.17 feet S.00° 34' E. & N. 57° 42' E.

891.4 feet & N. 6.0 feet from NW corner of NE 1/4 NE 1/4

Sec. 28

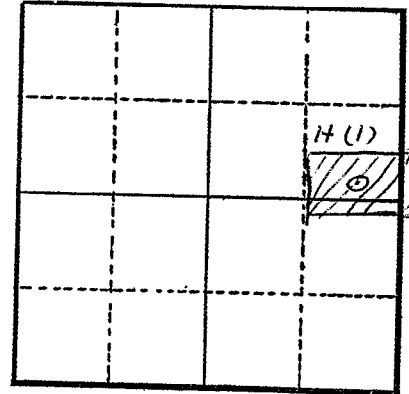

Section 28

Altitude at well 175

TYPE OF WELL: Drilled Date Constructed 1951

Depth drilled 134 Depth cased 134

### CASING RECORD:

10 inch

### FINISH:

Casing perforated 123 to 134

### AQUIFERS:

### WATER LEVEL:

34

PUMPING EQUIPMENT: Type Berkeley Centrifical

Capacity 900 G.P.M.

H.P. 25

### WELL TESTS:

Drawdown ..... ft. after ..... hours ..... G.P.M.

Drawdown ..... ft. after ..... hours ..... G.P.M.

USE OF WATER Irrigation - 55 acres Temp. .... °F. ...., 19

SOURCE OF INFORMATION Ground Water Registration Record

DRILLER or DIGGER

### ADDITIONAL DATA:

Log  Water Level Measurements ..... Chemical Analysis ..... Aquifer Test .....

### REMARKS:

