

STATE ENGINEER
Salem, Oregon

4496
MARI...96

Well Record

STATE WELL NO. 6/2W-28 K (1)
COUNTY Marion
APPLICATION NO. GR-55

OWNER: Glen M. Looney


MAILING ADDRESS: Route 6, Box 238

LOCATION OF WELL: Owner's No. 1

CITY AND STATE: Salem, Oregon

NW 1/4 SE 1/4 Sec. 28 T. 6 N. S., R. 2 E. W., W.M.

Bearing and distance from section or subdivision corner 10 chains east and 5 chains south from center of Section 28

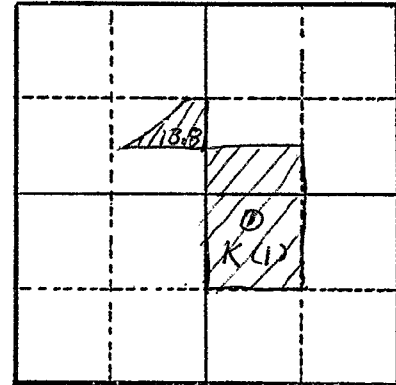

Section 28

Altitude at well 186 feet Interpolated

TYPE OF WELL: Drilled Date Constructed 5/23/39

Depth drilled 117' Depth cased 117'

CASING RECORD:

8-inch casing set from 0 to 117 feet.

FINISH:

Ripper perforations 3/8" x 8" and 6 rows per foot /18 perf. from 60' to 63' /12 perf. from 84' to 86'

AQUIFERS:

Gravel-

WATER LEVEL:

40 feet below land surface. May, 1939

PUMPING EQUIPMENT: Type Berkeley 3 phase H.P. 15
Capacity 240 G.P.M.

WELL TESTS:

Drawdown 108' ft. after 350 hours G.P.M.
Drawdown 96' ft. after 240 hours G.P.M.

USE OF WATER Irrigation - 74 acres Temp. °F. 19

SOURCE OF INFORMATION Registration Statement GR-47

DRILLER or DIGGER J. A. Sneed and Sons 2505 Brooks Street Salem, Oregon

ADDITIONAL DATA:

Log Water Level Measurements Chemical Analysis Aquifer Test

REMARKS:

See 6/2W-28 G-4902 & New file 1973

