

STATE ENGINEER
Salem, Oregon

MARI. 4500 Well Record

STATE WELL NO. 6/2W-28R
COUNTY Marion
~~APPLICATION NO.~~ GR-2657

OWNER: Clarence V. Zielinski


MAILING ADDRESS: Route 2, Box 437 **3 of 2**

LOCATION OF WELL: Owner's No. #1

CITY AND STATE: Salem, Oregon

SE 1/4 SE 1/4 Sec. 28 T. 6 ^N S, R. 2 ^E W., W.M.

Bearing and distance from section or subdivision corner 755.84 ft. N. 52° 10' W.

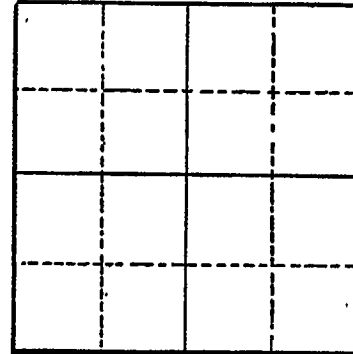

Section

Altitude at well

TYPE OF WELL: drilled Date Constructed 1946

Depth drilled 60' Depth cased 60'

CASING RECORD:

8 inch

FINISH:

AQUIFERS:

WATER LEVEL:

PUMPING EQUIPMENT: Type Pomona H.P. 15
Capacity 320 G.P.M.

WELL TESTS:

Drawdown 3 ft. after hours pumping 500 G.P.M.

Drawdown ft. after hours G.P.M.

USE OF WATER irrigation Temp. °F., 19.....

SOURCE OF INFORMATION GR-2519

DRILLER or DIGGER

ADDITIONAL DATA:

Log Water Level Measurements Chemical Analysis Aquifer Test

REMARKS:

STATE ENGINEER
Salem, Oregon

4500
MARI.....

Well Record

STATE WELL NO. 6/2W-28R(1)
COUNTY Marion
APPLICATION NO.

OWNER: C. V. Zielinski

MAILING ADDRESS:


Pg 2 of 2

LOCATION OF WELL: Owner's No.

CITY AND STATE:

..... ¼ Sec. T. N. S., R. E. W., W.M.

Bearing and distance from section or subdivision corner

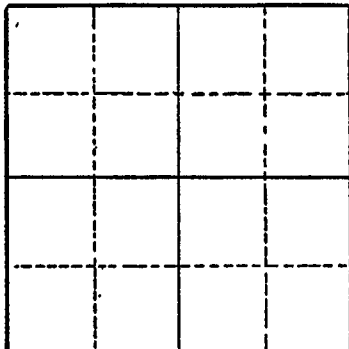

Altitude at well 150

TYPE OF WELL: Drilled Date Constructed 1946

Depth drilled 60 Depth cased

Section

CASING RECORD:

8 inch

FINISH:

AQUIFERS:

WATER LEVEL:
0 feet

PUMPING EQUIPMENT: Type Centrifugal H.P. 15
Capacity G.P.M.

WELL TESTS:

Drawdown ft. after hours G.P.M.
Drawdown ft. after hours G.P.M.

USE OF WATER Irrigation 50 acres Temp. °F., 19.....

SOURCE OF INFORMATION USGS

DRILLER or DIGGER

ADDITIONAL DATA:

Log Water Level Measurements Chemical Analysis Aquifer Test

REMARKS: