

STATE ENGINEER  
Salem, Oregon

MARI... 4532

# Well Record

STATE WELL NO. 6/2W-29G  
COUNTY Marion  
APPLICATION NO. GR-3730

OWNER: W. H. Lowery

MAILING ADDRESS:

Route 1, Box 206

LOCATION OF WELL: Owner's No.


CITY AND STATE:

Brooks, Oregon

SE 1/4 NE 1/4 Sec. 29 T. 6 S. R. 2 W., W.M.

Bearing and distance from section or subdivision

corner 550' E. & 10' S. of NE Cor. DLG # 37

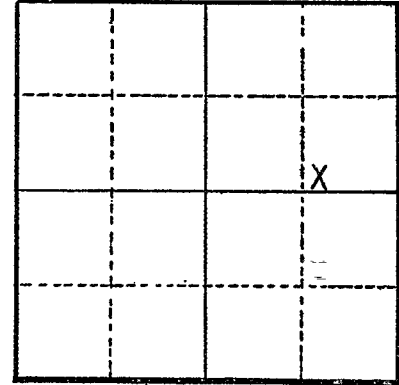

Section 29

Altitude at well

TYPE OF WELL: Drilled Date Constructed 4/17/45

Depth drilled 73 ft. Depth cased 73 ft.

### CASING RECORD:

10 inch steel casing set to 73 feet

### FINISH:

Casing perforated from 1 to 20 feet

### AQUIFERS:

### WATER LEVEL:

Approx. 7 feet below surface

PUMPING EQUIPMENT: Type Fairbanks Morse centrifugal H.P. 1 1/2  
Capacity 350 G.P.M.

### WELL TESTS:

Drawdown 8 ft. after 350 hours G.P.M.

Drawdown ft. after hours G.P.M.

USE OF WATER Irrigation Temp. °F., 19

SOURCE OF INFORMATION Well Registration Statement

DRILLER or DIGGER Evans

### ADDITIONAL DATA:

Log Water Level Measurements Chemical Analysis Aquifer Test

### REMARKS:

3204