

STATE ENGINEER
Salem, Oregon

MAR 4 5 33 Well Record

STATE WELL NO. 6/2W-29G
COUNTY Marion
APPLICATION NO. GR-1552

GR- 1496

OWNER: Ronald E. Jones


MAILING ADDRESS: P. O. Box 98

LOCATION OF WELL: Owner's No.

CITY AND STATE: Brooks, Oregon

SW 1/4 NE 1/4 Sec. 29 T. 6 S, R. 2 W., W.M.

Bearing and distance from section or subdivision corner 11.428 ch. N. & 25.344 ch. N. 29°13' W. & 6.1 ch. S. 78°20' W. & 9.925 ch. S. 74°21' W. & 5.43 ch. S. 3°10' E. & 0.38 ch. W. from NE cor. of the W. Morgan DLC. #71.

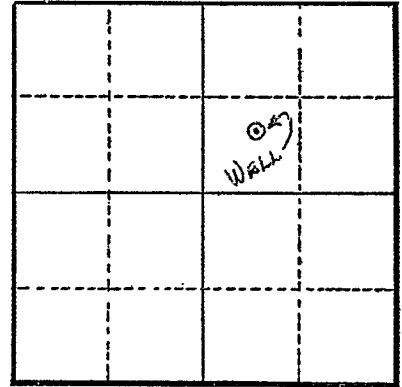

Section 29

Altitude at well 190'

TYPE OF WELL: Drilled Date Constructed 1945

Depth drilled 125' Depth cased 125'

CASING RECORD:
12"

FINISH:

AQUIFERS:

WATER LEVEL:
10'

PUMPING EQUIPMENT: Type Turbine H.P. 10
Capacity 400 G.P.M.

WELL TESTS:
Drawdown 30 ft. after 400 hours G.P.M.
Drawdown ft. after hours G.P.M.

USE OF WATER Irrigation Temp. °F., 19

SOURCE OF INFORMATION GR Record

DRILLER or DIGGER

ADDITIONAL DATA:

Log N.A. Water Level Measurements Chemical Analysis Aquifer Test

REMARKS:

Irrigation of 25 acres.