

STATE ENGINEER  
Salem, Oregon

MAR 5 1953

# Well Record

STATE WELL NO. 6/2W-29K  
COUNTY Marion  
APPLICATION NO. GR-1553

GR- 1497

OWNER: Ronald E. Jones

MAILING ADDRESS: P. O. Box 98


LOCATION OF WELL: Owner's No.

CITY AND STATE: Brooks, Oregon

NW 1/4 SE 1/4 Sec. 29 T. 6 S., R. 2 W., W.M.

Bearing and distance from section or subdivision

corner 11.428 ch. N. & 25.344 ch. N. 29°13'W. &  
6.1 ch. S. 78°20'W. & 14.885 ch. S. 74°21'W. &  
34.59 ch. S. 4'E. & 0.11 ch. W. from the NE.  
cor. of the W. Morgan DLC. #71.

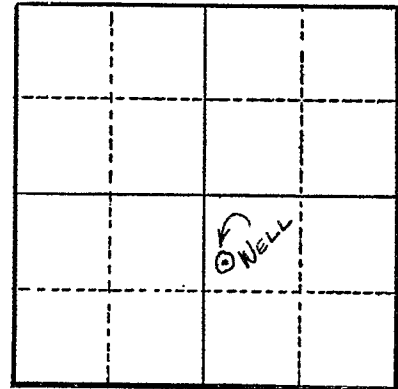

Altitude at well 190' - 140'

Section 29

TYPE OF WELL: Drilled. Date Constructed 1945

Depth drilled 125' Depth cased 75'

CASING RECORD:  
12"

FINISH:

AQUIFERS:

WATER LEVEL:  
10'

PUMPING EQUIPMENT: Type Cent. H.P. 10  
Capacity 600 G.P.M.

WELL TESTS:  
Drawdown 4 ft. after 600 hours G.P.M.  
Drawdown ft. after hours G.P.M.

USE OF WATER Irrigation Temp. °F. 19

SOURCE OF INFORMATION GR Record

DRILLER or DIGGER

ADDITIONAL DATA:

Log N.A. Water Level Measurements Chemical Analysis Aquifer Test

REMARKS:

Irrigation of 25 acres.