

STATE ENGINEER
Salem, Oregon

4537
MAR 1938
Well Record

STATE WELL NO. 6/2W-29L
COUNTY Marion
APPLICATION NO. GR-3114

OWNER: J. A. Rickard


MAILING ADDRESS: Route 1, Box 260

LOCATION OF WELL: Owner's No.

CITY AND STATE: Brooks, Oregon

NE 1/4 SW 1/4 Sec. 29 T. 6 S., R. 2 W., W.M.

Bearing and distance from section or subdivision
corner 29 Ch. N. and 5.5 ch. W. from S 1/4 Corner
Sec. 29

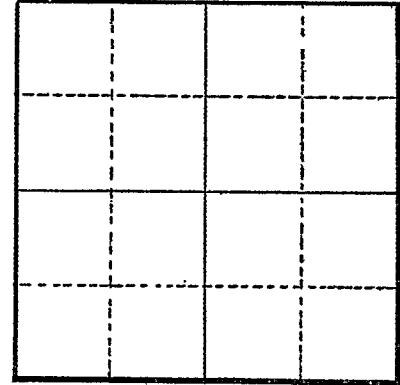

Section

Altitude at well

TYPE OF WELL: drilled Date Constructed 1938

Depth drilled 60' Depth cased 60'

CASING RECORD:

8"

FINISH:

AQUIFERS:

WATER LEVEL:

4'

PUMPING EQUIPMENT: Type Goulds 1 1/2" Centrifugal H.P. 5
Capacity 130 G.P.M.

WELL TESTS:

Drawdown 2 ft. after pumping 500 hours G.P.M.

Drawdown ft. after hours G.P.M.

USE OF WATER Irrigation Temp. °F., 19

SOURCE OF INFORMATION GR-2922

DRILLER or DIGGER

ADDITIONAL DATA:

Log Water Level Measurements Chemical Analysis Aquifer Test

REMARKS: