

STATE ENGINEER
Salem, Oregon

MAR. 4.538
Well Record

STATE WELL NO. 6/2W-29L
COUNTY Marion
APPLICATION NO. GR-1635

GR- 1600

OWNER: A. O. Lowery


MAILING ADDRESS: Rt. 2, Box 367

LOCATION OF WELL: Owner's No.

CITY AND STATE: Salem, Oregon

NE 1/4 SW 1/4 Sec. 29 T. 6 S., R. 2 W., W.M.

Bearing and distance from section or subdivision corner 1800' N. & 550' W. from S 1/4 cor. Sec. 29

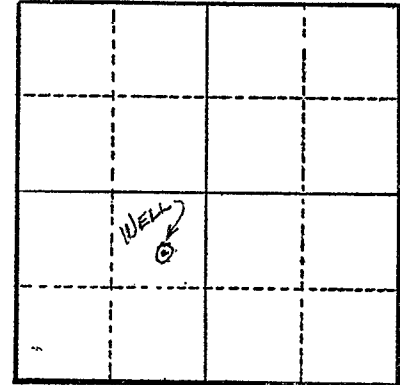

Section 29

Altitude at well

TYPE OF WELL: Drilled Date Constructed 1930's

Depth drilled 80' Depth cased 80'

CASING RECORD:

8"

FINISH:

AQUIFERS:

WATER LEVEL:

5'

PUMPING EQUIPMENT: Type Cent. H.P. 5
Capacity 100 G.P.M.

WELL TESTS:

Drawdown ft. after hours G.P.M.
Drawdown ft. after hours G.P.M.

USE OF WATER Irrigation Temp. °F. 19

SOURCE OF INFORMATION GR Record

DRILLER or DIGGER

ADDITIONAL DATA:

Log N.A. Water Level Measurements Chemical Analysis Aquifer Test

REMARKS:

Irrigation of 4 acres