

STATE ENGINEER
Salem, Oregon

ARI... 4542

Well Record

STATE WELL NO. 6/ZW-29F
COUNTY Marion
APPLICATION NO. GR-3570

OWNER: G. A. and Helen Russ


MAILING ADDRESS: Route 1, Box 176 Pg 1 of 2

LOCATION OF WELL: Owner's No.

CITY AND STATE: Brooks, Oregon

1/4 Sec. 29 T. 6 S., R. 2 W., W.M.

Bearing and distance from section or subdivision corner 3155 ft. S. 53° 30' E. from NW corner of section 29

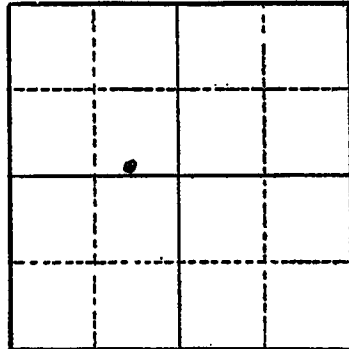

Section 29

Altitude at well

TYPE OF WELL: Drilled Date Constructed 1950

Depth drilled 68 ft. Depth cased 68 ft.

CASING RECORD:

6 inch casing set to 68 feet

FINISH:

AQUIFERS:

WATER LEVEL:

12 feet below surface

PUMPING EQUIPMENT: Type Fairbanks Morse Centrifugal H.P. 30
Capacity 350 G.P.M.

WELL TESTS:

Drawdown 6 ft. after 250 hours G.P.M.

Drawdown ft. after hours G.P.M.

USE OF WATER Irrigation Temp. °F. 19

SOURCE OF INFORMATION Well Registration Statement

DRILLER or DIGGER Oval Wymore

ADDITIONAL DATA:

Log Water Level Measurements Chemical Analysis Aquifer Test

REMARKS:

STATE ENGINEER
Salem, Oregon

MARI. 4542 Well Record

STATE WELL NO. 6/2W-29F(1)
COUNTY Marion
APPLICATION NO.

OWNER: G. A. Russ

MAILING ADDRESS:
CITY AND STATE:

pg 2 of 2

LOCATION OF WELL: Owner's No. _____
N. E.
S, R. W., W.M.
Bearing and distance from section or subdivision corner

Altitude at well 160

TYPE OF WELL: Drilled. Date Constructed 1950
Depth drilled 68 Depth cased

Section

CASING RECORD:

6 inch

FINISH:

Open bottom, casing unperforated

AQUIFERS:

WATER LEVEL:

7.15 feet below land surface on July 29, 1960

PUMPING EQUIPMENT: Type Centrifugal H.P. 30
Capacity G.P.M.

WELL TESTS:

Drawdown ft. after hours G.P.M.
Drawdown ft. after hours G.P.M.

USE OF WATER Irrigation 12 acres Temp. °F., 19

SOURCE OF INFORMATION USGS

DRILLER or DIGGER

ADDITIONAL DATA:

Log Water Level Measurements Chemical Analysis Aquifer Test

REMARKS: