

STATE ENGINEER  
Salem, Oregon

MAR 1 4573

# Well Record

STATE WELL NO. ...6/2W-30H...  
COUNTY ...Marion...  
APPLICATION NO. ...GR-1550...

GR- 1494

OWNER: J. J. Mathis


MAILING ADDRESS: Rt. 2, Box 338

LOCATION OF WELL: Owner's No.

CITY AND STATE: Salem, Oregon

SE 1/4 NE 1/4 Sec. 30 T. 6 S, R. 2 W., W.M.

Bearing and distance from section or subdivision corner 2450' S. & 300' W. from NE cor. Sec. 30

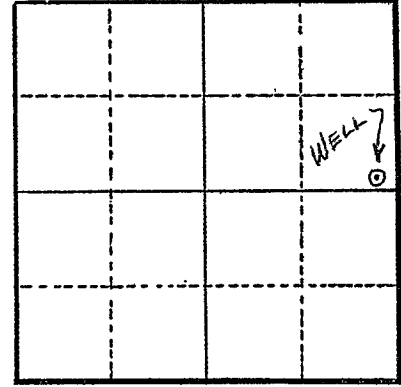

Altitude at well 155'

TYPE OF WELL: Drilled Date Constructed 1947

Depth drilled 74' Depth cased 74'

Section 30

### CASING RECORD:

8"

### FINISH:

### AQUIFERS:

### WATER LEVEL:

21.00 (7-28-60)

PUMPING EQUIPMENT: Type Cent. H.P. 24  
Capacity 300 G.P.M.

### WELL TESTS:

Drawdown	61	ft. after	hours	445	G.P.M.
Drawdown	47	ft. after	hours	325	G.P.M.
	24			223	

USE OF WATER Irrigation Temp. °F. 19

SOURCE OF INFORMATION GR Record

DRILLER or DIGGER Wymore

### ADDITIONAL DATA:

Log N.A. Water Level Measurements Chemical Analysis Aquifer Test

### REMARKS:

Irrigation of 30 acres.