

STATE ENGINEER
- Salem, Oregon

4576
MAR 1949
Well Record

STATE WELL NO. 6/2W-30K
COUNTY Marion
APPLICATION NO. GR-3295

OWNER: Labish Village Water Com.

MAILING

ADDRESS: 7065 Blossom St.

% Charles E. Cheek, Treas.

CITY AND

LOCATION OF WELL: Owner's No.


STATE: Salem, Oregon

NW 1/4 SE 1/4 Sec. 30 T. 6 S. R. 2 W., W.M.

Bearing and distance from section or subdivision

corner 27' 6" S. & 7' E. from NW Cor. Lot 16

Block 5, Labish Village

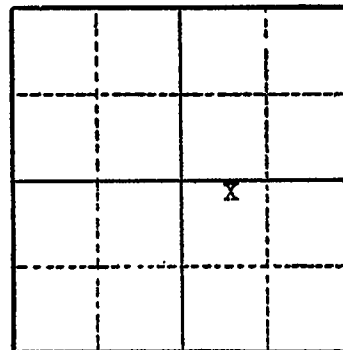

Section 30

Altitude at well

TYPE OF WELL: Drilled Date Constructed 1949

Depth drilled 52 ft. Depth cased 52 ft.

CASING RECORD:

6 in. 1-D casing set to 52 feet

FINISH:

No perforations

AQUIFERS:

WATER LEVEL:

18 feet below surface

PUMPING EQUIPMENT: Type Jet

H.P. 2

Capacity 25 G.P.M.

WELL TESTS:

Drawdown 28 ft. after 50 hours G.P.M.

Drawdown ft. after hours G.P.M.

USE OF WATER Municipal Temp. °F. 19

SOURCE OF INFORMATION Well Registration Statement Cert. # GR-3791

DRILLER or DIGGER J. A. Sneed & Sons

ADDITIONAL DATA:

Log X Water Level Measurements Chemical Analysis Aquifer Test

REMARKS: Log

Top soil
Clay yellow color
Clay blue
Cemented gravel first 2"
Sand medium grain
Water gravel first 2"

Thickness Depth to Bottom

2 2
28 30
8 38
10 48
2 50
2 52