

STATE ENGINEER
Salem, Oregon

MAR. 4585 Well Record

STATE WELL NO. 6/2W-30 R. (1)
COUNTY Marion
APPLICATION NO. GR-487

OWNER: David & Wilma Turnidge

MAILING
ADDRESS:


LOCATION OF WELL: Owner's No. #13

CITY AND
STATE:

Jefferson, Oregon

SE 1/4 SE 1/4 Sec. 30 T. 6 S., R. 2 W., W.M.

Bearing and distance from section or subdivision
corner 872' N. & 660' W of SE corner, Sec. 30

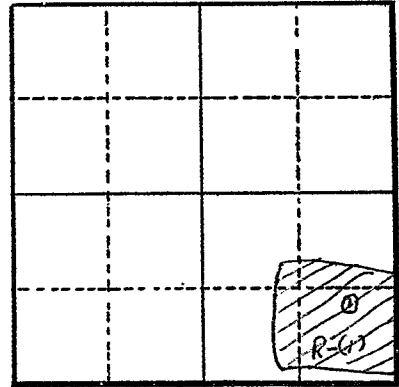

Section 30

Altitude at well 145

TYPE OF WELL: Drilled Date Constructed 1952

Depth drilled 62 Depth cased 62

CASING RECORD:

12-inch

FINISH:

AQUIFERS:

WATER LEVEL:

20

PUMPING EQUIPMENT: Type Hercules H.P. 30

Capacity 625 G.P.M.

WELL TESTS:

Drawdown ft. after hours G.P.M.

Drawdown ft. after hours G.P.M.

USE OF WATER Irrigation- 81.0 acres Temp. °F., 19

SOURCE OF INFORMATION Ground Water Registration Statement GR-469

DRILLER or DIGGER

ADDITIONAL DATA:

Log X Water Level Measurements Chemical Analysis Aquifer Test

REMARKS:

Soil 0' to 22'
Sand & Gravel 22' to 62'