

STATE ENGINEER
Salem, Oregon

4626
MAR 1950

Well Record

STATE WELL NO. 6/2W-31L
COUNTY Marion
APPLICATION NO. GR-1410

GR- 1365

OWNER: Clyde Kunze


MAILING ADDRESS: 3225 Chemawa Rd. Pg 1 of 2

LOCATION OF WELL: Owner's No. #1

CITY AND STATE: Salem, Oregon

NE 1/4 SW 1/4 Sec. 31 T. 6 S., R. 2 W., W.M.

Bearing and distance from section or subdivision corner 1500' E. & 400' S. from W^{1/2} cor. Sec. 31

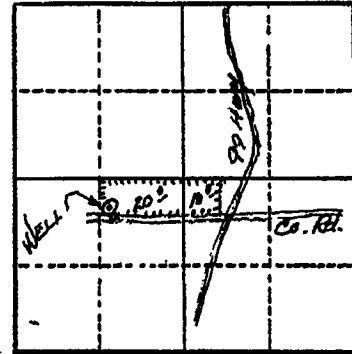

Section 31

Altitude at well

TYPE OF WELL: Drilled Date Constructed 1949

Depth drilled 120 ft. Depth cased 120 ft.

CASING RECORD:

12 inch

FINISH:

Mills knife perforations from 69 to 71.

AQUIFERS:

WATER LEVEL:

11 ft.

PUMPING EQUIPMENT: Type Jacuzzi submersible H.P. 10
Capacity 380 G.P.M.

WELL TESTS:

Drawdown 27 ft. after 360 hours G.P.M.

Drawdown ft. after hours G.P.M.

USE OF WATER Irrigation & Industrial Temp. °F. 19

SOURCE OF INFORMATION G. R. Record

DRILLER or DIGGER Wymore

ADDITIONAL DATA:

Log N.A. Water Level Measurements Chemical Analysis Aquifer Test

REMARKS:

Irrigation of 30 acres.

STATE ENGINEER
Salem, Oregon

4626
MAR 1949

Well Record

STATE WELL NO. 6/2W-31M(1).
COUNTY Marion
APPLICATION NO.

Pg 2 of 2

OWNER: Clyde Kumze

MAILING ADDRESS:
CITY AND STATE:

LOCATION OF WELL: Owner's No. _____
N. E.
S, R. W., W.M.

Bearing and distance from section or subdivision corner _____

Altitude at well 155'

TYPE OF WELL: Drilled Date Constructed 1949

Depth drilled 120 Depth cased _____

Section _____

CASING RECORD:

12 inch

FINISH:

Casing perforated 69 to 71

AQUIFERS:

WATER LEVEL:

PUMPING EQUIPMENT: Type Submersible H.P. 10
Capacity _____ G.P.M.

WELL TESTS:
Drawdown _____ ft. after _____ hours _____ G.P.M.
Drawdown _____ ft. after _____ hours _____ G.P.M.

USE OF WATER Irrigation--30 acres Temp. _____ °F. _____, 19_____

SOURCE OF INFORMATION USGS

DRILLER or DIGGER _____

ADDITIONAL DATA:

Log _____ Water Level Measurements _____ Chemical Analysis _____ Aquifer Test _____

REMARKS: