
STATE ENGINEER Salem, Oregon

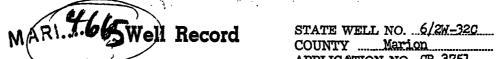

		APPLICATION NO. CR-3751		751
Owners Mag Fred Declah	MAILING	6630 Lake Labish	5.3	Polot
OWNER: Mrs. Fred Pacleb	ADDRESS:	QQJV_LAK9_LADISN		*************
LOCATION OF WELL: Owner's No	CITY AND STATE:	Salem, Oregon		
NE 1/4 NW 1/4 Sec. 32 T. 6 S, R. 2 W.	. w.m.	1		
Bearing and distance from section or subdivision	,	X		
corner E. 1845; and S. 705! from NW.cor.	Sec32			
				
				
Altitude at well	***********			
TYPE OF WELL:Dr4lled. Date Constructed .19	ł5			
Depth drilled 80 feet Depth cased		Section 32	••••	
CASING RECORD:				
FINISH:				
AQUIFERS:				
WATER LEVEL:		· • • • • • • • • • • • • • • • • • • •	,	
WATER LEVEL: 75 feet below surface				
		_		
PUMPING EQUIPMENT: Type		J	1.P5	, ,
WELL TESTS:	1			CDM
Drawdown ft. after ft. after				
				Mariana .
JSE OF WATER Irrigation SOURCE OF INFORMATION Well Registrate ORILLER or DIGGER	ion Statement			
ADDITIONAL DATA: Log Water Level Measurements	Chemical Ana	lysis Aquife	r Test	•
REMARKS:				

STATE ENGINEER MAR. T. Salem, Oregon	5 Well Record	STATE WELL NO6/ COUNTY Marion APPLICATION NO	
OWNER: Fred Pacleb	MAILING ADDRESS:	Po	2 sf
LOCATION OF WELL: Owner's No			
	_		1
Bearing and distance from section or subd	\$.		
corner	1		
			1
Altitude at well 148			
TYPE OF WELL-Prilled Date Const	_]
Depth drilled <u>80</u> Depth cased	***************************************	Section	
CASING RECORD:			
8 inch			
FINISH:			· · · · · · · · · · · · · · · · · · ·
 \ \			
AQUIFERS:			
WATER LEVEL:		, ,	
5 feet			
PUMPING EQUIPMENT: Type	Centrifugal	H.P	5
Capacity G.P.M.			
WELL TESTS: Drawdown ft. after	hours		(J.P.1
Drawdown ft. after			CPI

USE OF WATER Irrigation--15 acres Temp. °F. ,19.

DRILLER or DIGGER

ADDITIONAL DATA:

REMARKS: