

STATE ENGINEER
Salem, Oregon

MARI...⁴⁶⁷⁹ Well Record

STATE WELL NO. 6/2W-32M(1)
COUNTY ... Marion ...
APPLICATION NO. ... GR-795 ...

OWNER: L.V. and Donna Lemire


MAILING ADDRESS: 4960 Hazel Green Rd.

LOCATION OF WELL: Owner's No. #1

CITY AND STATE: Salem, Oregon

NW 1/4 SW 1/4 Sec. 32 T. 6 N S, R. 2 W, W.M.

Bearing and distance from section or subdivision corner 23.82 ch. to W corner of sec. 32 N 39°58' W

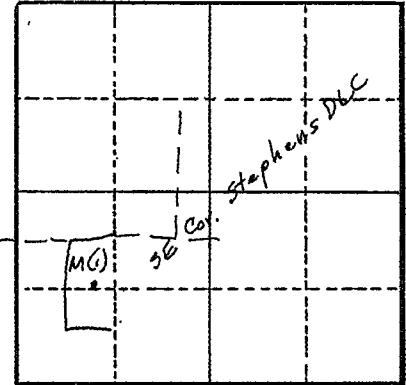

Section 32

Altitude at well 185 feet

TYPE OF WELL: Drilled Date Constructed Apr. 1951

Depth drilled 110 ft. Depth cased 110 ft.

CASING RECORD:

8 inch

FINISH:

390 holes 79 to 100 ft.

AQUIFERS:

WATER LEVEL:

35 feet

PUMPING EQUIPMENT: Type 3 ph. elect.- Deep well pump H.P. 7 1/2

Capacity 450 G.P.M.

WELL TESTS:

Drawdown 30 ft. after 450 hours G.P.M.

Drawdown ft. after hours G.P.M.

USE OF WATER Irrigation - 15 acres Temp. °F. 19

SOURCE OF INFORMATION GR-795

DRILLER or DIGGER

ADDITIONAL DATA:

Log YES Water Level Measurements Chemical Analysis Aquifer Test

REMARKS:

