

STATE ENGINEER
Salem, Oregon

4687
MARI....

Well Record

STATE WELL NO. 6/2W-32 R. (1)
COUNTY Marion
APPLICATION NO. GR-770

OWNER: Ed V. Zielinski


MAILING ADDRESS: 5610 Hazel Green Road

LOCATION OF WELL: Owner's No. 1

CITY AND STATE: Salem, Oregon

SE 1/4 SE 1/4 Sec. 32 T. 6 N. S. R. 2 W., W.M.

Bearing and distance from section or subdivision corner 980' W & 540' N from SE corner of Section 32.

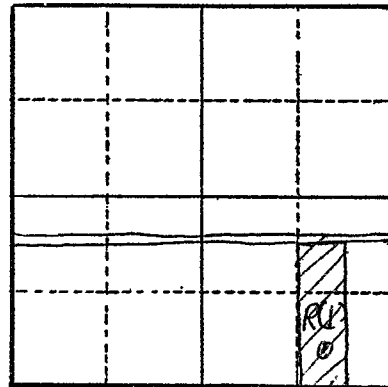

Section 32

Altitude at well 178 feet Interpolated

TYPE OF WELL: Drilled Date Constructed 8/1/45

Depth drilled 98' Depth cased 98'

CASING RECORD:

8 inch

FINISH:

perforated 70' to 75'

AQUIFERS:

WATER LEVEL:

33 feet

PUMPING EQUIPMENT: Type Electric - turbine pump H.P. 10
Capacity 120 G.P.M.

WELL TESTS:

Drawdown 42 ft. after 120 hours G.P.M.

Drawdown ft. after hours G.P.M.

USE OF WATER Irrigation Temp. °F., 19

SOURCE OF INFORMATION Registration Statement GR-745

DRILLER or DIGGER Chester Pugh

ADDITIONAL DATA:

Log yes Water Level Measurements Chemical Analysis Aquifer Test

REMARKS:

