

STATE ENGINEER
Salem, Oregon

MARI. 4683

Well Record

STATE WELL NO. 6/2W - 32F
COUNTY MARION
APPLICATION NO. GR-2225

OWNER: E. L. Jordan


MAILING ADDRESS: 6435 Lake Labish Road

LOCATION OF WELL: Owner's No.

CITY AND STATE: Salem, Oregon

SE 1/4 NW 1/4 Sec. 32 T. 6 N. S. R. 2 W., W.M.

Bearing and distance from section or subdivision corner 1760' S. and 840' W.

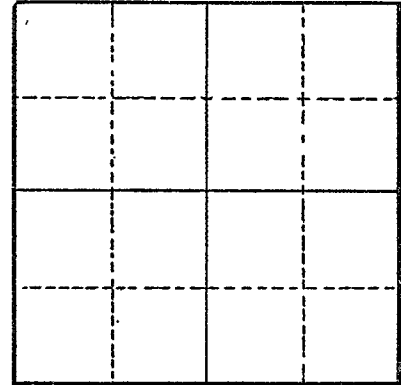

Section

Altitude at well 175'

TYPE OF WELL: Drilled Date Constructed 1955

Depth drilled 71 Depth cased 71

CASING RECORD:

6*Inch

FINISH:

AQUIFERS:

Clay and sand

WATER LEVEL:

18-Feet (7-1-55)

PUMPING EQUIPMENT: Type Jacuzzi Bros. (Jet) H.P. 3
Capacity 60 G.P.M.

WELL TESTS:

Drawdown 6 ft. after hours Pumping 60 G.P.M.
Drawdown ft. after hours G.P.M.

USE OF WATER Irrigation - 9 acres Temp. °F., 19

SOURCE OF INFORMATION GR-2131

DRILLER or DIGGER Orville Wymore, Rt. 1, Box 1, Brooks, Oregon

ADDITIONAL DATA:

Log Water Level Measurements Chemical Analysis Aquifer Test

REMARKS:

Top soil	0	3
Yellow silt	3	18
Yellow clay	18	40
Blue clay	40	62
Brown sand	62	68
Brown sand & Gravel	68	71