

STATE ENGINEER  
Salem, Oregon

MARI. 4684 Well Record

STATE WELL NO. 6/2W-32 L (1)  
COUNTY Marion  
APPLICATION NO. GR-305

OWNER: Victor L. Ramey


MAILING ADDRESS: 5150 Hazel Green

LOCATION OF WELL: Owner's No. 1

CITY AND STATE: Salem, Oregon

NE 1/4 SW 1/4 Sec. 32 T. 6 S., R. 2 W., W.M.

Bearing and distance from section or subdivision corner S 89°06' W 3752.81 feet & S 18°35' E 699.80 feet from NE Corner of W. B. Stephens DLC #48.

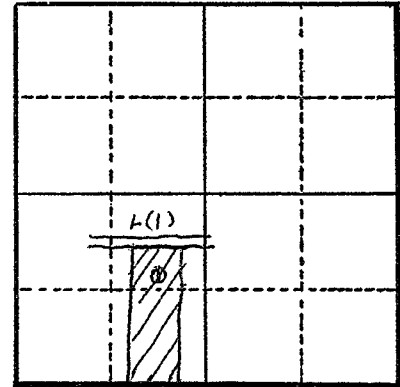

Altitude at well 180 feet Interpolated

TYPE OF WELL: Drilled Date Constructed Sept., 1951

Depth drilled 103 Depth cased 100

Section 32

CASING RECORD:

8-inch steel casing from 0 to 100 feet

FINISH:

390 perforations set from 79 to 100 feet

AQUIFERS:

Sand and gravel from 75 to 103 feet.

WATER LEVEL:

35 feet below land surface.

PUMPING EQUIPMENT: Type Jacuzzi Deep Well Turbine H.P. 7 1/2

Capacity 300 G.P.M.

WELL TESTS:

Drawdown 65 ft. after hours pumping 450 G.P.M.

Drawdown ft. after hours G.P.M.

USE OF WATER Irrigation-39.46 acres Temp. °F., 19

SOURCE OF INFORMATION Registration Statement GR-284

DRILLER or DIGGER Wymore, Salem, Oregon

ADDITIONAL DATA:

Log X Water Level Measurements Chemical Analysis Aquifer Test

REMARKS:

Soil 0 to 3 feet  
Shale, brown, blue 3 to 75 feet  
Sand and gravel 75 to 103 feet