

STATE ENGINEER
Salem, Oregon

4685
MAR... Well Record

STATE WELL NO. 6/2W-32 Q (1)
COUNTY Marion
APPLICATION NO. GR-334

OWNER: Peter Reitzenstein


MAILING ADDRESS: 5430 Hazel Green Road

LOCATION OF WELL: Owner's No. #1

CITY AND STATE: Salem, Oregon

SW 1/4 SE 1/4 Sec. 32 T. 6 N. R. 2 E. W., W.M.

Bearing and distance from section or subdivision corner 2270 feet west & 1060 feet south of NE corner of W. B. Stephens DLC 48

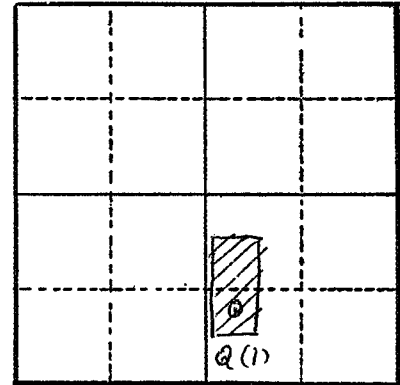

Altitude at well 180 feet Interpolated

TYPE OF WELL: Drilled Date Constructed 10/30/53

Depth drilled 95 Depth cased 95

Section 32

CASING RECORD:

8-inch steel casing from 0 to 95 feet

FINISH:

Mills Knife 8 slots per row - 15 rows

AQUIFERS:

Sand and gravel 71 to 95 feet

WATER LEVEL:

35 feet below land surface. 10/30/53

PUMPING EQUIPMENT: Type Jacuzzi 5" Turbine H.P. 15
Capacity 500 G.P.M.

WELL TESTS:

Drawdown ft. after hours G.P.M.
Drawdown ft. after hours G.P.M.

USE OF WATER Irrigation, 20 acres Temp. °F., 19

SOURCE OF INFORMATION Registration Statement GR-319

DRILLER or DIGGER Wymore; Salem, Oregon

ADDITIONAL DATA:

Log Yes Water Level Measurements Chemical Analysis Aquifer Test

REMARKS:

