

STATE ENGINEER
Salem, Oregon

MARI... 4702

Well Record

STATE WELL NO. 6/2W-33C
COUNTY Marion
APPLICATION NO. GR-3287

OWNER: Dorothy B. Zielinski


MAILING ADDRESS: 1105 Columbia Street

LOCATION OF WELL: Owner's No.

CITY AND STATE: Salem, Oregon

NE 1/4 NW 1/4 Sec. 33 T. 6 N. S, R. 2 E. W., W.M.

Bearing and distance from section or subdivision corner 650' W. & 20' N. from SE cor. NE 1/4 NW 1/4

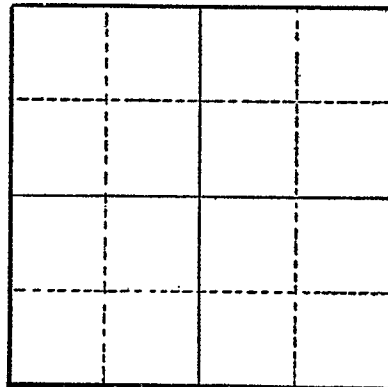

Section

Altitude at well 184

TYPE OF WELL: Drilled Date Constructed 1953

Depth drilled 135 Depth cased 135

CASING RECORD:

8 inch

FINISH:

Perforated from 80' to the bottom almost solid

AQUIFERS:

WATER LEVEL:

30 feet

PUMPING EQUIPMENT: Type Berkeley Turbine H.P. 15
Capacity 240 G.P.M.

WELL TESTS:

Drawdown 130 ft. after hours Pumping 350 G.P.M.

Drawdown ft. after hours G.P.M.

USE OF WATER Irrigation Temp. °F. 19

SOURCE OF INFORMATION GR-3056

DRILLER or DIGGER Studerbaker Brothers

ADDITIONAL DATA:

Log Water Level Measurements Chemical Analysis Aquifer Test

REMARKS: