


STATE ENGINEER  
Salem, Oregon

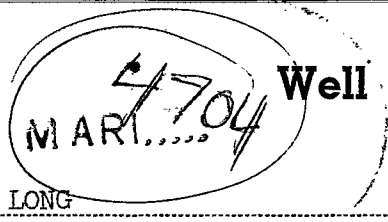

# Well Record

STATE WELL NO. 6/2W-33E(1)  
COUNTY Marion  
APPLICATION NO. \_\_\_\_\_

OWNER: E. N. LONG

MAILING ADDRESS: \_\_\_\_\_

LOCATION OF WELL: Owner's No. \_\_\_\_\_

CITY AND STATE: \_\_\_\_\_

..... 1/4 ..... 1/4 Sec. .... T. .... N. S., R. .... E. W., W.M.

Bearing and distance from section or subdivision

corner \_\_\_\_\_

Altitude at well 178


TYPE OF WELL: Drilled Date Constructed \_\_\_\_\_

Section \_\_\_\_\_

Depth drilled ..... Depth cased .....

CASING RECORD:

FINISH:

AQUIFERS:

WATER LEVEL:

PUMPING EQUIPMENT: Type Turbine H.P. 15  
Capacity ..... G.P.M.

WELL TESTS:

Drawdown ..... ft. after ..... hours ..... G.P.M.

Drawdown ..... ft. after ..... hours ..... G.P.M.

USE OF WATER Irrigation Temp. ..... °F. ...., 19.....

SOURCE OF INFORMATION USGS

DRILLER or DIGGER \_\_\_\_\_

ADDITIONAL DATA:

Log ..... Water Level Measurements  ..... Chemical Analysis ..... Aquifer Test .....

REMARKS:

